


One (1) Set of Approved Building plans must remain on construction site during construction.

526380
 Disposed
 Training Department
 25 DW
 48 CC
 Approved: RJE
 Disposed:
 if denied, applicant notified
 of reasons (S)
 19
 52

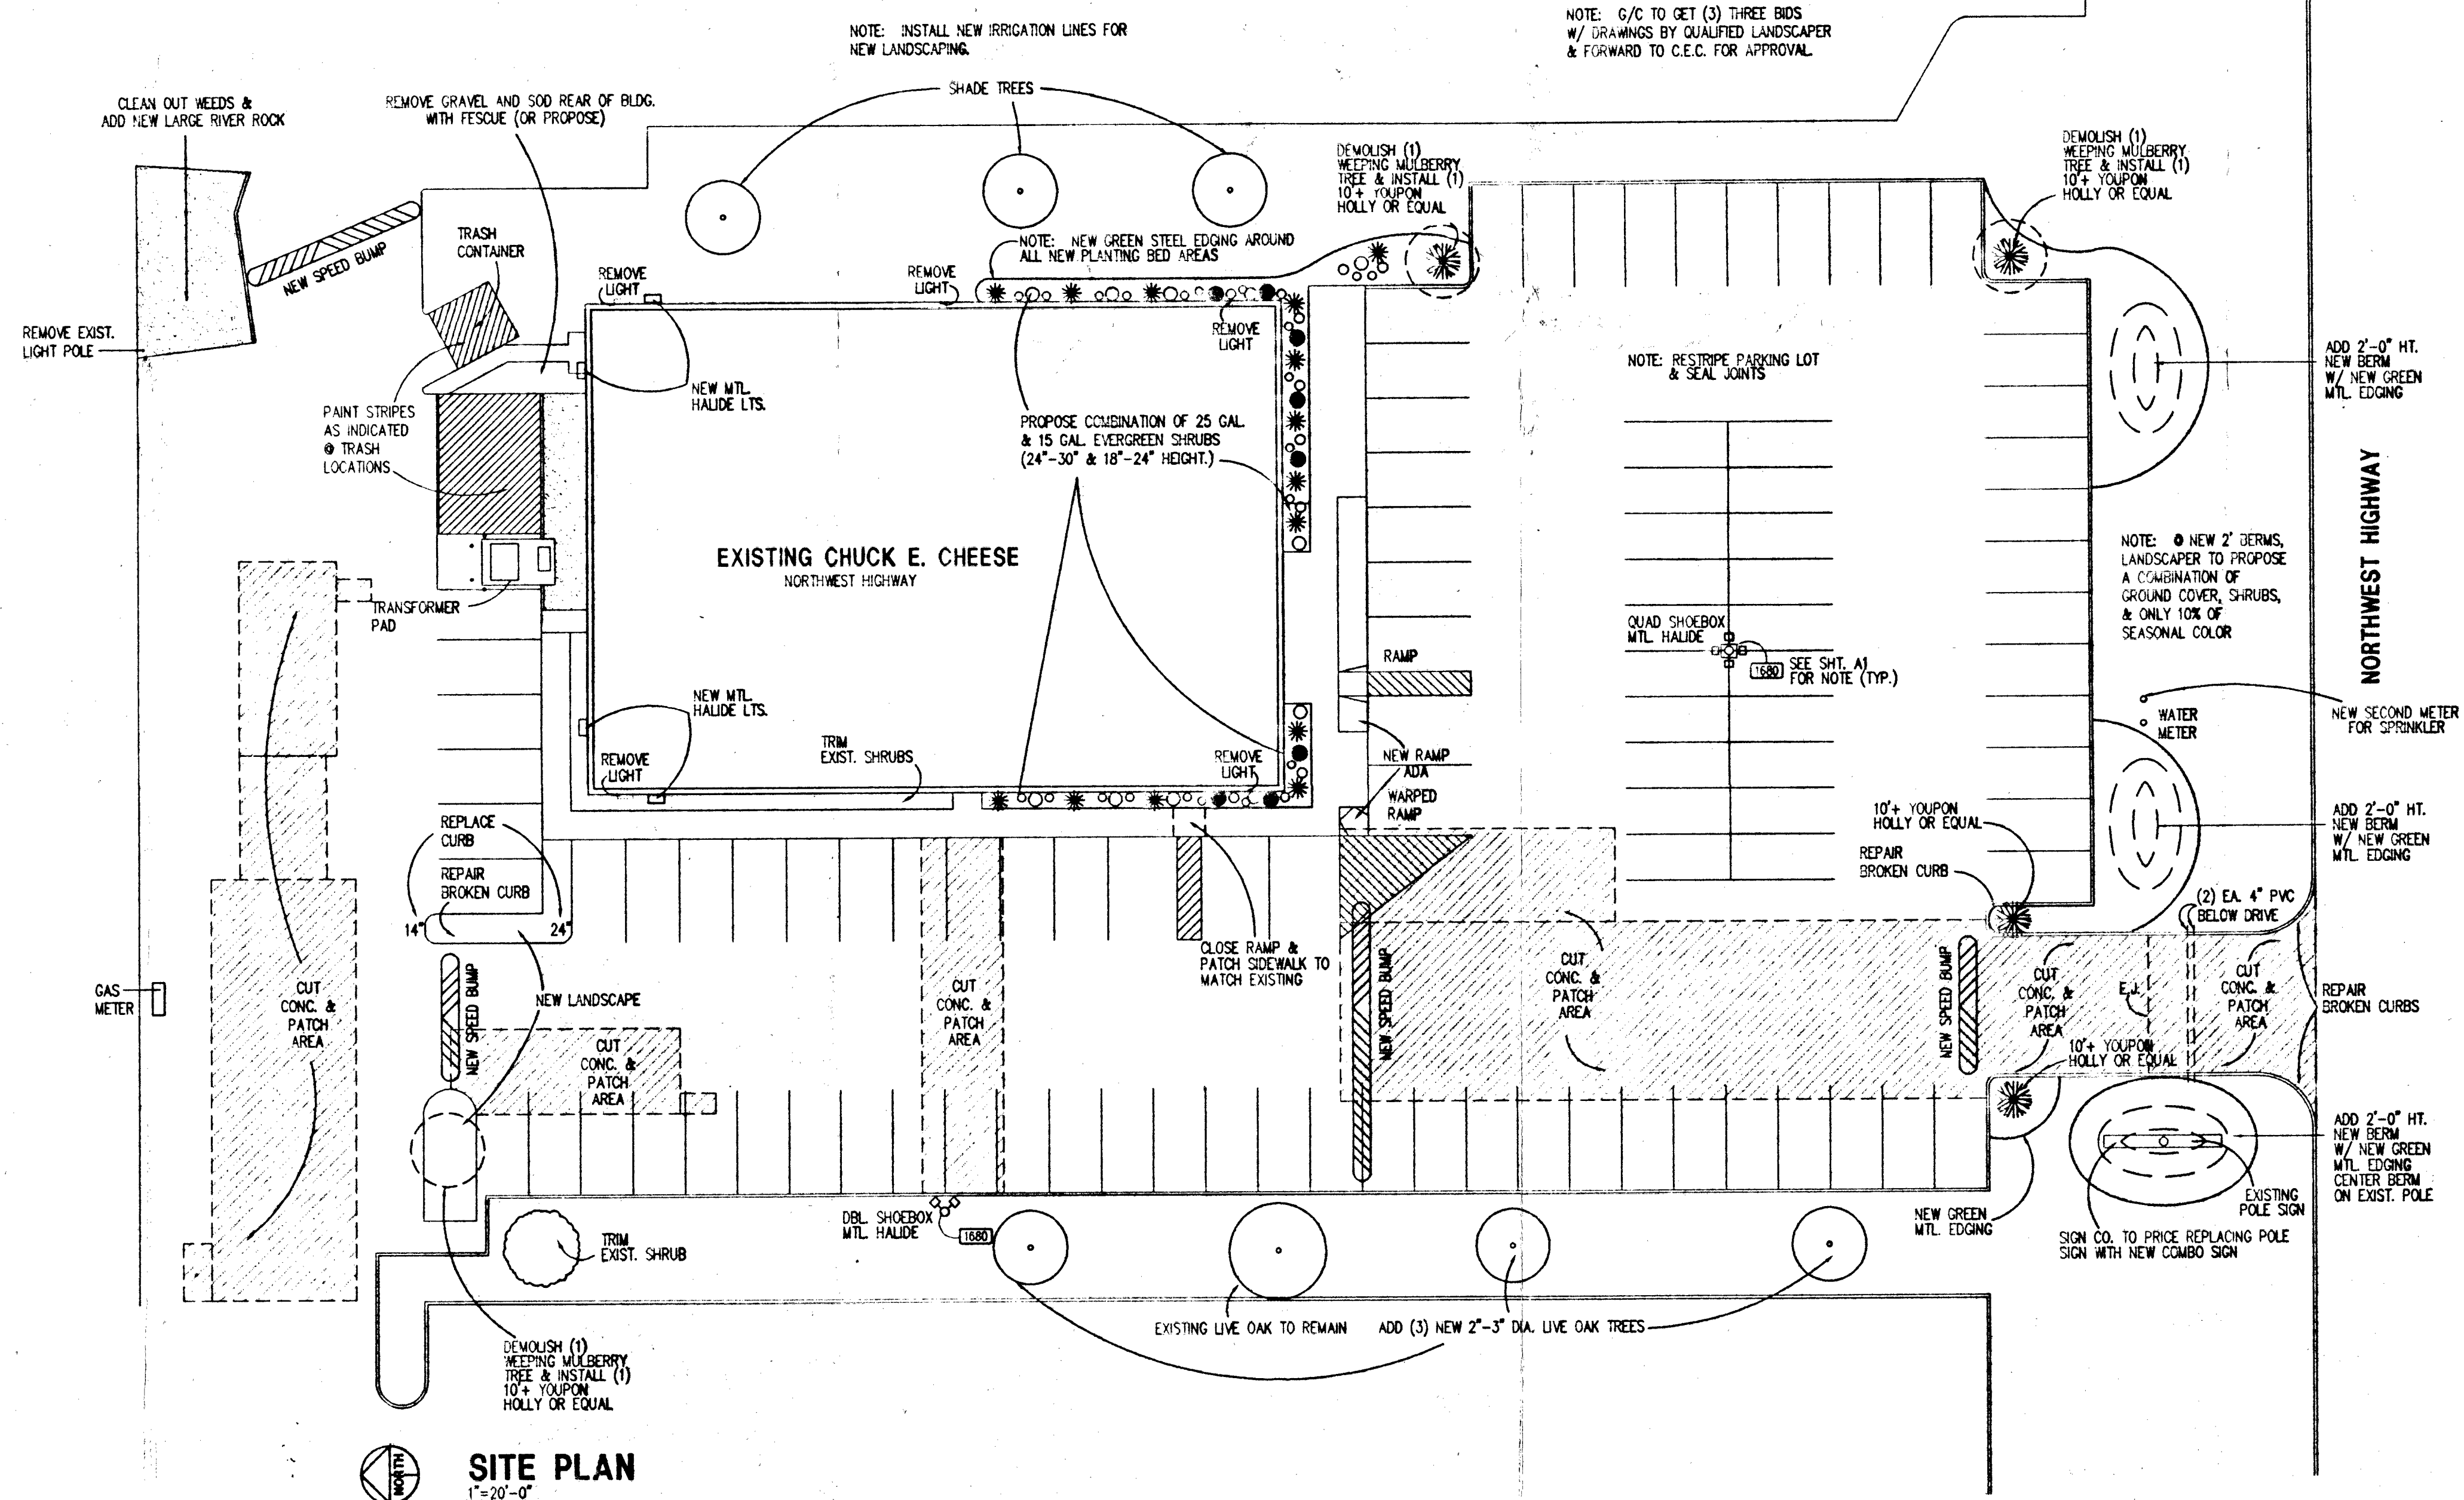


C.T. CHANG, A.I.A.
1010 EULESS BOULEVARD, SUITE 110
EULESS, TX 76040 817 354-6010

CHUCK E. CHEESE'S PIZZA.
6917 N. W. EYDESSWAY
#889

CHUCK E. CHEESE'S
6897 N. W. EXPRESSWAY
OKLAHOMA CITY, OK 73132

C. E. C. ENTERTAINMENT, INC.
4441 WEST AIRPORT FREEWAY
IRVING, TEXAS 75062

SITE PLAN

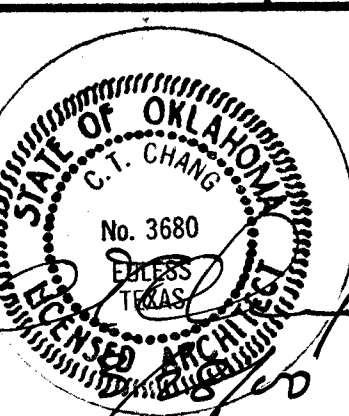

Date 03/28/00


Revisions

Project Number
CB-889

Sheet Number

C1

THESE DOCUMENTS ARE THE SOLE PROPERTY OF CEC ENTERTAINMENT, INC.. ANY COPYING OR USE OF THESE DOCUMENTS FOR ANY PURPOSE OTHER THAN CONSTRUCTION OF THIS PROJECT WITHOUT EXPRESS WRITTEN PERMISSION OF CEC ENTERTAINMENT, INC. IS PROHIBITED.

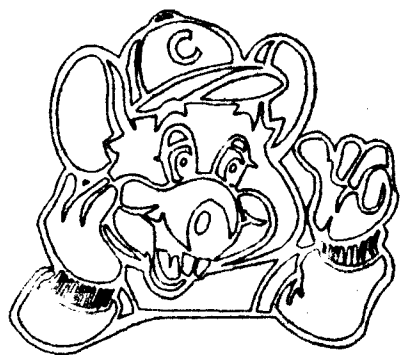


ARCHITECTURE - PLANNING - DESIGN
C.T. CHANG & ASSOC., INC.
1010 W. EULESS BLVD., SUITE 110
EULESS, TX 76040

CHUCK E. CHEESE'S PIZZA
8817 N. W. EXPRESSWAY
OKLAHOMA CITY, OK 73122
C. E. C. ENTERTAINMENT, INC.
4441 WEST AIRPORT FREEWAY
IRVING, TEXAS 75062

OKLAHOMA CITY, OK

DEMOLITION PLAN

#889

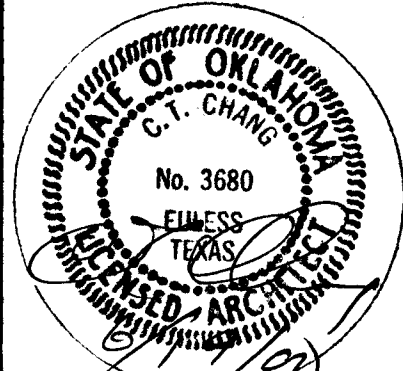

Date: 03/28/00

Revisions:

NO.	DATE	REVISION
1	06/16/00	REVISION

Project Number: SB-889

Sheet Number: D1 of 8

THESE DOCUMENTS ARE THE SOLE PROPERTY OF CEC ENTERTAINMENT, INC. ANY COPYING OR USE OF THESE DOCUMENTS FOR ANY PURPOSE OTHER THAN CONSTRUCTION OF THIS PROJECT WITHOUT EXPRESSED WRITTEN PERMISSION OF THE ARCHITECT AND CEC ENTERTAINMENT, INC. IS PROHIBITED.

FLOOR DEMOLITION NOTES:

0000

GENERAL DEMOLITION NOTES:

- Beginning of demolition means installer accepts existing conditions.
- Demolish indicated structures and fixtures in an orderly and careful manner.
- Protect existing landscape materials, appurtenances, and structures which are not to be demolished.
- Erect weatherproof closures for exterior openings created by demolition work.
- Promptly remove and dispose of contaminated, vermin infested, or dangerous materials.
- Do not burn or bury materials on site.
- Remove all floor finishes down to substrate.
- Remove walls and structures down to surface which may be refinished.
- Do not cut structural members until adequate bracing has been installed.

Mechanical Demolition Notes:

- Disconnect, remove, and cap designated utilities and fixtures within demolition areas.
- Mark location of disconnected utilities.

Electrical Demolition Notes:

- Remove abandoned wiring to source of supply.
- Verify that abandoned wiring and equipment serves only abandoned facilities.
- Coordinate utility service outages with Utility Company.
- Cut conduit flush with or beneath walls and floors, and refinish surfaces.

Contaminated materials:

- When encountered, inform owner of presence of contaminated materials.
- Contaminated materials are to be removed by others.
- Verify that previously removed materials are acceptable prior to commencement of demolition work.

SECTION 2 DEMOLITION/SITEWORK/REMOVAL

- 0201 REMOVE EXISTING DOOR(S) & HARDWARE. PREPARE FOR NEW WORK.
- 0202 REMOVE EXISTING DOOR(S), FRAME(S) & HARDWARE. PREPARE FOR NEW WORK.
- 0204 REMOVE EXISTING WINDOW. PREPARE FOR NEW WORK.
- 0205 REMOVE EXISTING WALL/PARTITION TO LIMITS SHOWN. PATCH AND REPAIR FOR NEW WORK.
- 0206 REMOVE EXISTING HALF WALL TO LIMITS SHOWN. PATCH & REPAIR FOR NEW WORK.
- 0210 SIGN CO. TO REMOVE EXTERIOR AWNING. PATCH & REPAIR FOR NEW WORK.
- 0216 REMOVE EXISTING CARPET TO LIMITS AS INDICATED.
- 0230 REMOVE INTERIOR SIGNAGE, INCLUDING EMPLOYEE PLAQUES, LICENSES, ETC. SAVE FOR DECOR VENDOR TO REINSTALL. PATCH & REPAIR SURFACE FOR NEW WORK.
- 0231 REMOVE DECOR ITEMS (AS INDICATED). SAVE FOR REINSTALL BY DV. PATCH AND REPAIR SURFACE FOR NEW WORK.


SECTION 4 MASONRY

- 0232 REMOVE PORTIONS OF WALL TO LIMITS SHOWN.
- 0238 REMOVE EXISTING WOOD CAP. SAVE FOR REINSTALLATION.
- 0241 REMOVE EXISTING "THANK YOU BOX". PATCH & REPAIR WALL FOR NEW WORK.
- 0246 REMOVE EXISTING SALAD BAR TOP. PREPARE FOR NEW INSTALLATION.
- 0261 BLANK COVER PLATE TO BE REMOVED, PATCHED, TEXTURED & PAINTED.
- 0262 DEMO EXISTING STEPS & ASSOCIATED RAILING AS INDICATED.
- 0280 REMOVE EXISTING ELECT. SERVICE PANELS "T1", "T2" AND "T3". RELOCATE AS PER SHT. A1. RECONNECT TO EXISTING FEED.
- 0281 REMOVE EXIST. PORTION OF "KIDCHECK" ROPE & POSTS AS INDICATED.
- 0286 REMOVE EXISTING PICK-UP SHELF. RELOCATE AS PER SHT. A1.
- 0289 DEMO EXISTING RAISED DINING PLATFORM AS INDICATED.
- 0481 SAWCUT EXISTING BRICK WAINSCOT TO FIT NEW PILASTERS AS REQUIRED.


CEILING DEMOLITION NOTES:

0000

- 0219 REMOVE EXISTING CEILING TILE & GRID AS INDICATED. RE-ADJUST GRID AS INDICATED ON SHT. A3.
- 0220 REMOVE EXISTING MONITOR. SAVE FOR RELOCATION AS SHOWN. SEE SHT. A3.
- 0221 REMOVE EXISTING SPEAKER. SAVE FOR RELOCATION.
- 0223 REMOVE EXISTING LIGHTS & RELOCATE FIXTURES AS SHOWN.
- 0225 REMOVE EXISTING TRACK LIGHT FIXTURE AS INDICATED. SAVE FOR RELOCATION.
- 0236 REMOVE EXISTING "EYEBALL" LIGHTS AS INDICATED.
- 0283 REMOVE (5) EXISTING ROOF MOUNTED BUILDING LIGHTS.
- 0287 REMOVE EXISTING 2x4 LAY-IN FIXTURE AS SHOWN. REPLACE WITH TILE TO MATCH EXISTING.
- 0292 REMOVE EXISTING MONOPOINT FIXTURE AS INDICATED.

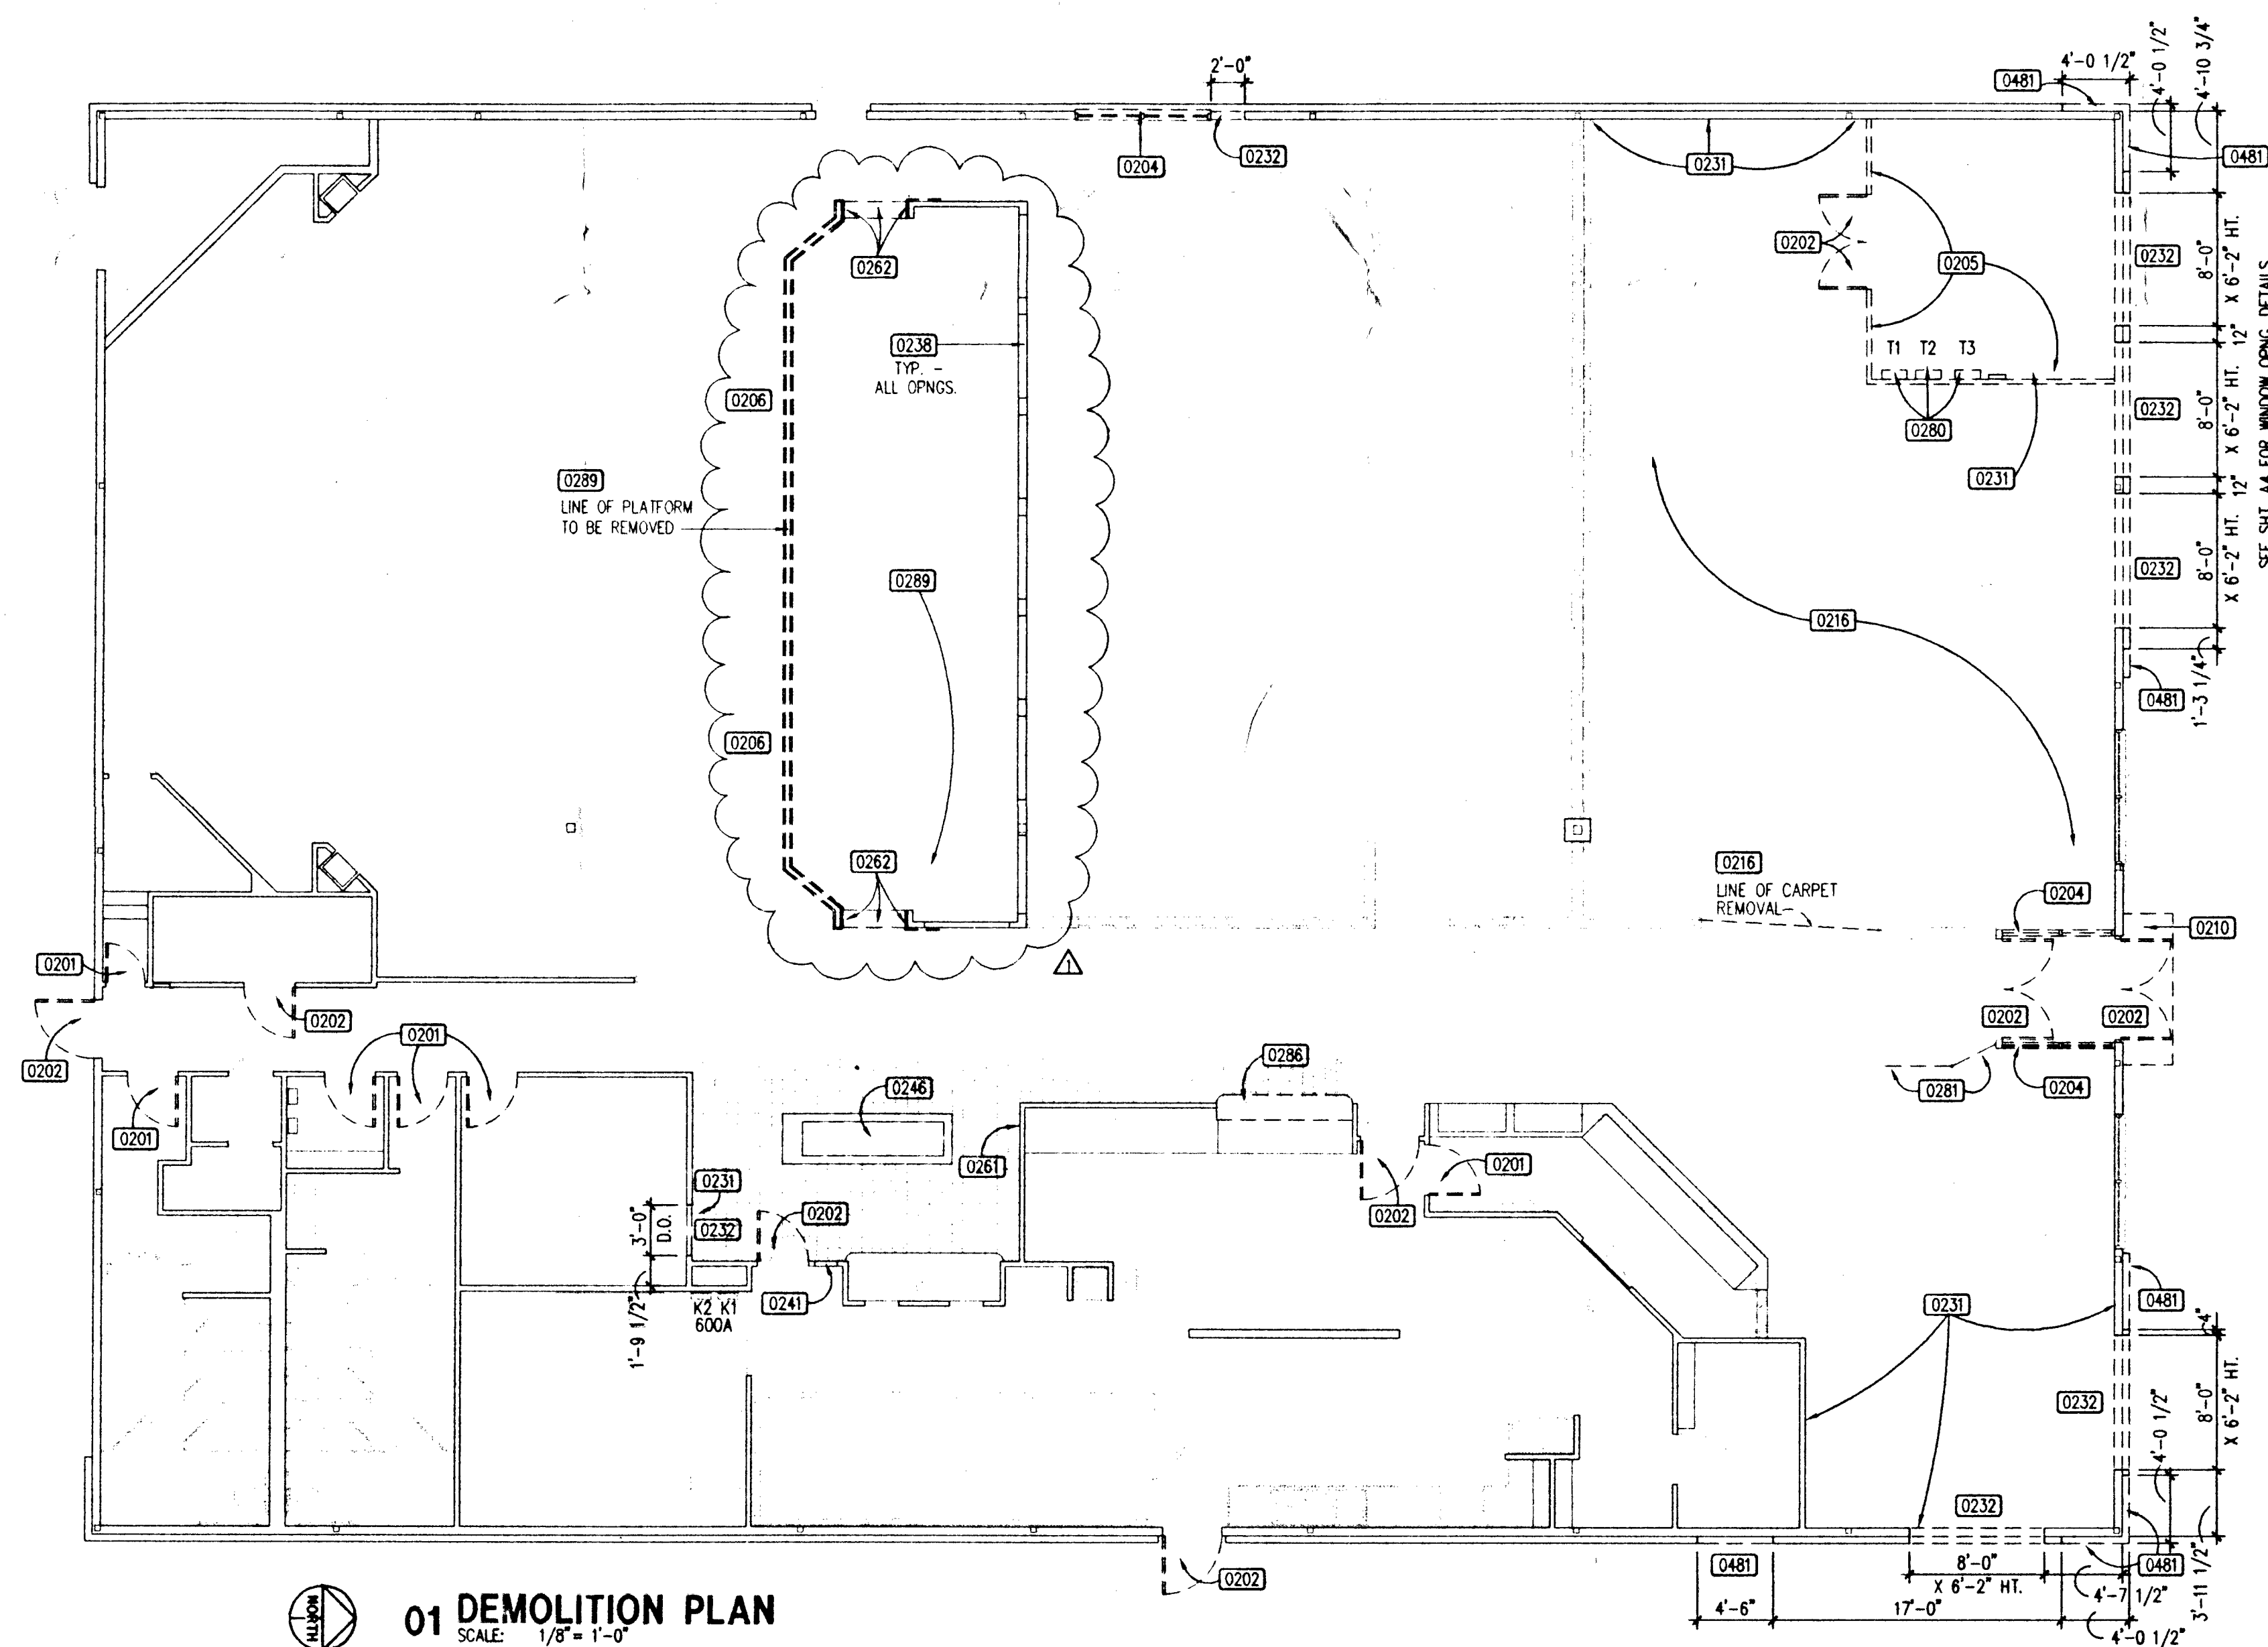

01 DEMOLITION PLAN
SCALE: 1/8" = 1'-0"

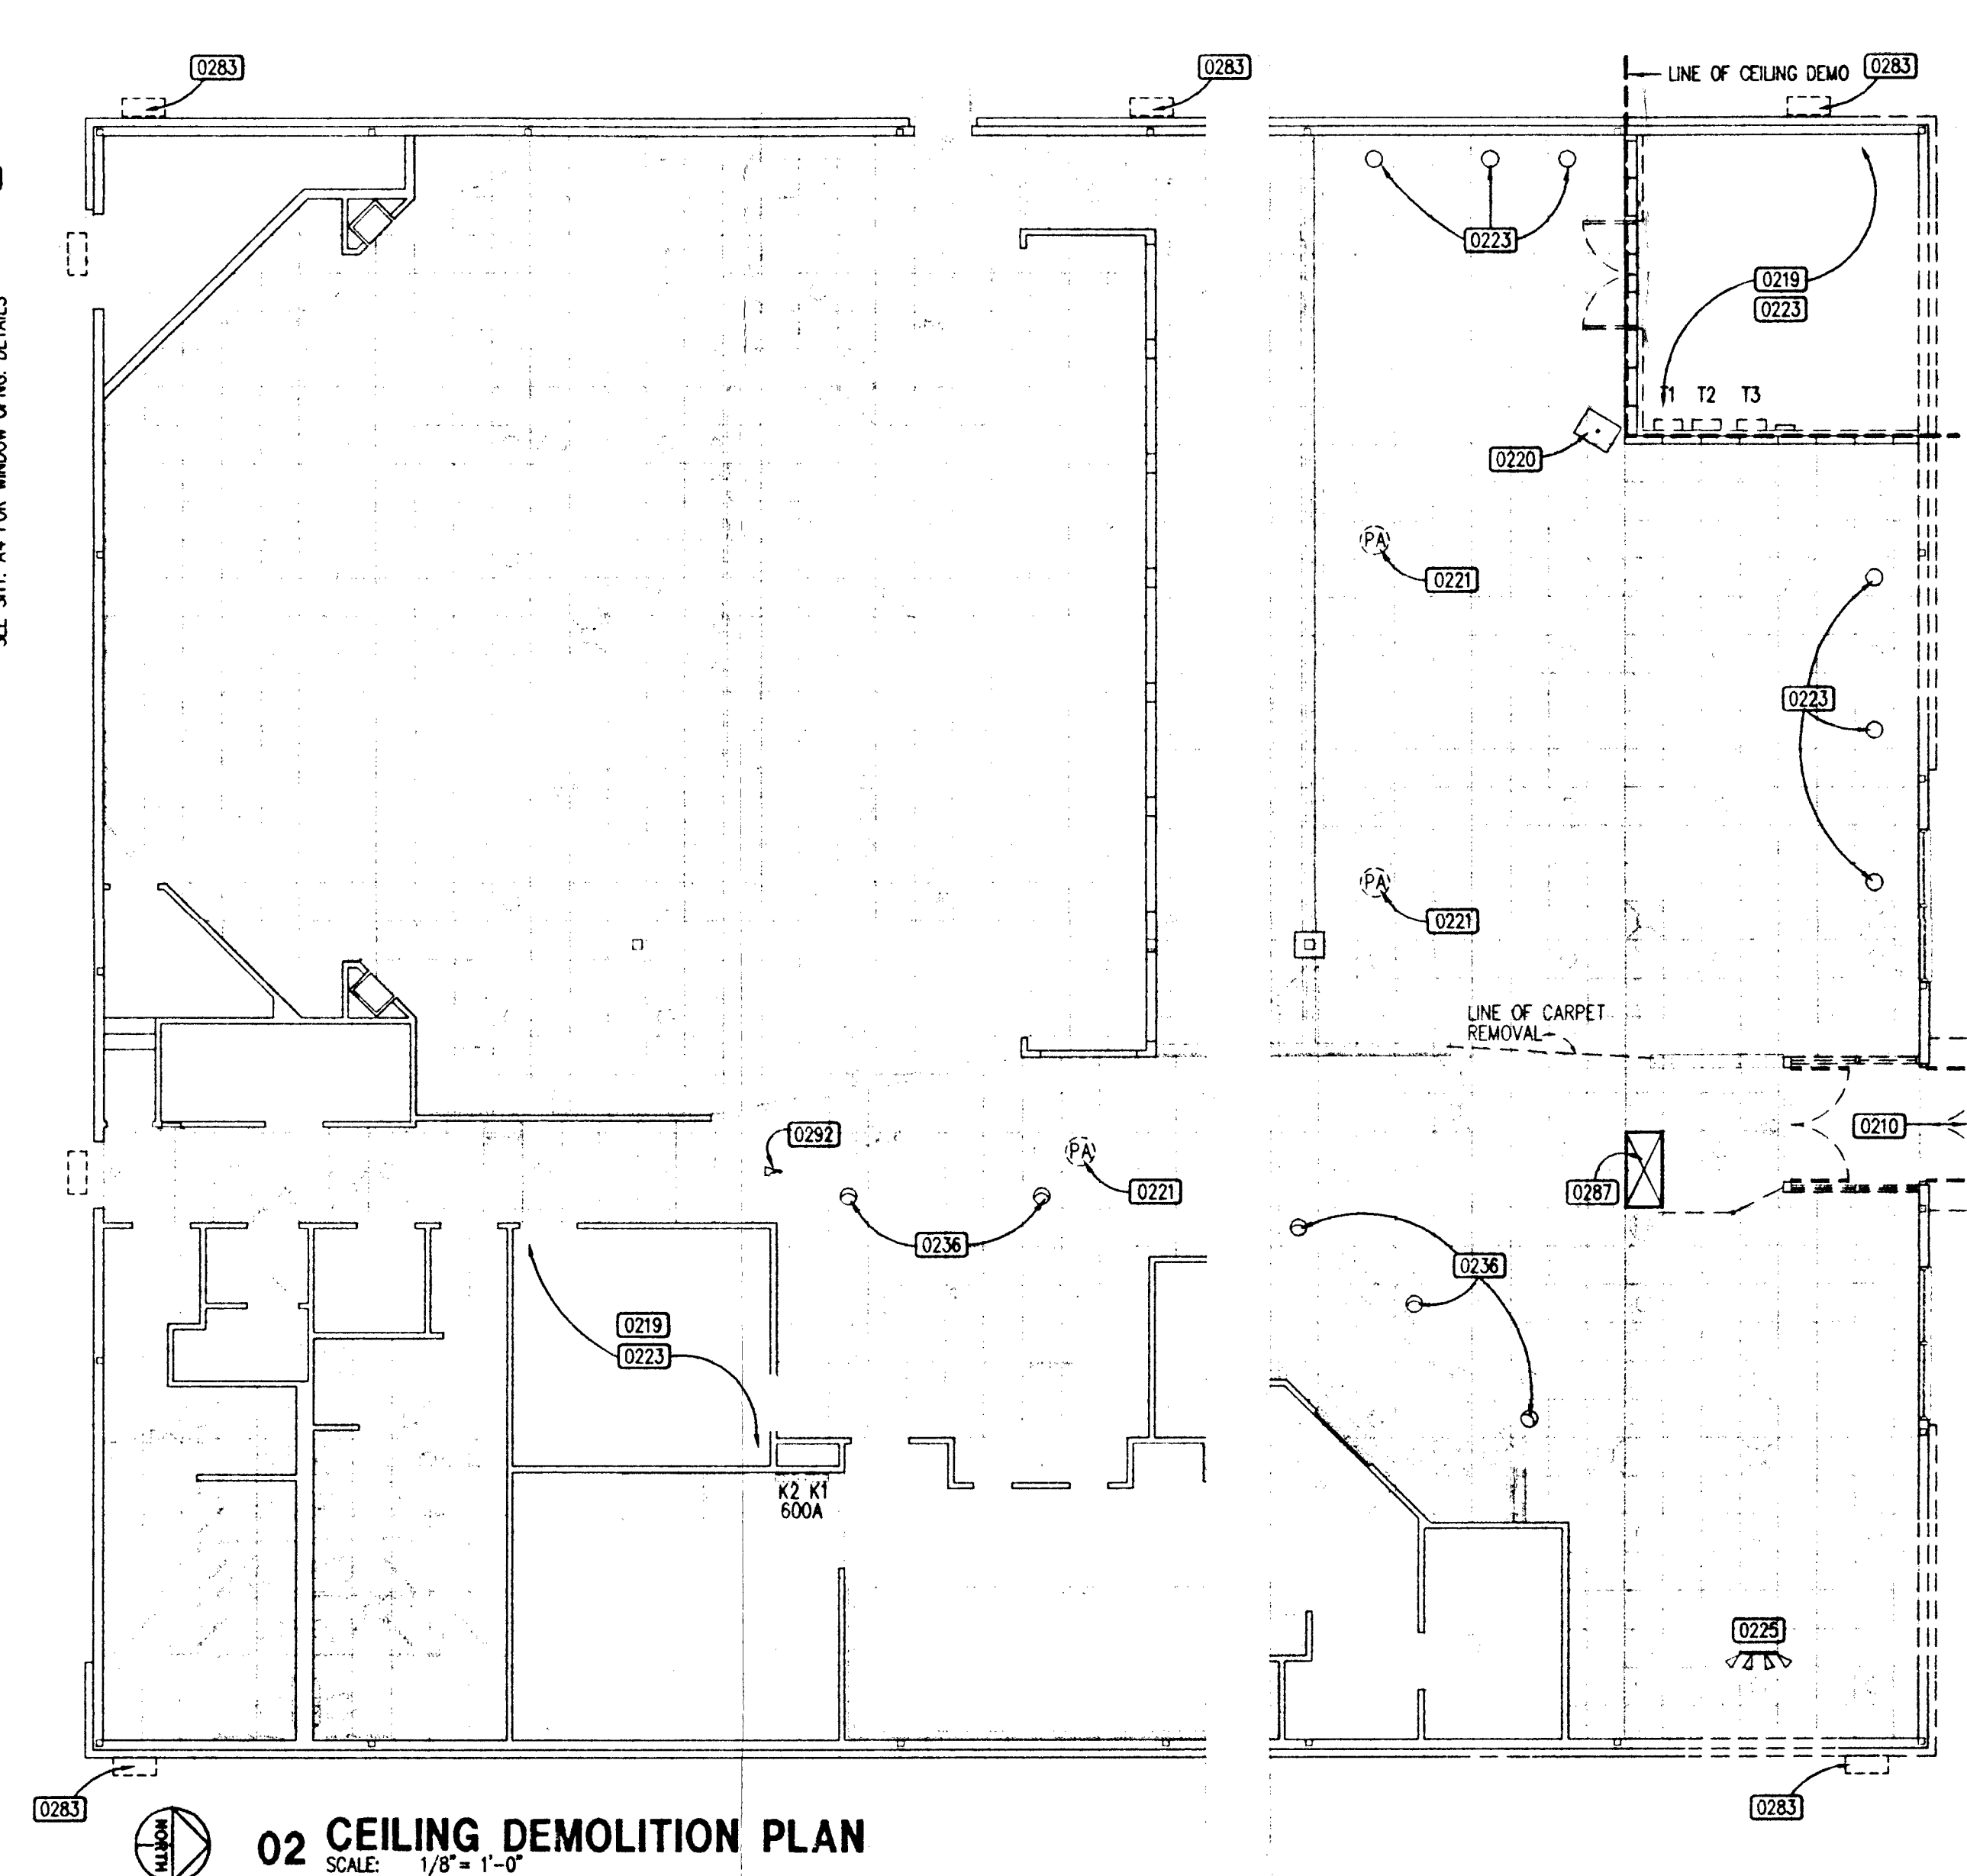

02 CEILING DEMOLITION PLAN
SCALE: 1/8" = 1'-0"

CHECKED
DRAWING DIVISION
ZONED: C-3 (COM. COM.)
REGULATIONS OF SECTION 9200.12.A
SHALL BE COMPLIED WITH:
APPROVED: RSK
DENIED:
Applicant notified of action taken on: 12



ARCHITECTURE - PLANNING - DESIGN
C.T. CHANG, A.I.A.
1010 EULESS BOULEVARD, SUITE 100
EULESS, TX 76040

GENERAL NOTES AND COMMENTS AS PER CITY REQUIREMENTS:
POSTING STRUCTURE - OCCUPANT LOAD MUST BE POSTED AS PER 1996 BOCA SECTION 1008.0
OCC. LOAD: 350
MINIMUM UNIFORMLY DISTRIBUTED LIVE LOADS MUST BE: LIVE LOAD 100 PSF AS PER 1996 BOCA
SECTION 1606.0
STRUCTURES MUST COMPLY WITH ENERGY CONSERVATION REQUIREMENTS AS PER CHAPTER 13, 1996 BOCA.
SMOKE DETECTORS REQUIRED AS PER ORD. #15500
INSTALL SAFETY GLAZING AS REQUIRED AS PER 1996 BOCA SECTION 2405.0
EMERGENCY EGRESS LIGHTING & ILLUM. EXIST SIGNS TO COMPLY W/ CITY LOCAL CODES.
PANIC HARDWARE REQUIRED EXITS.

NOTICE
One (1) Set of Approved
Building plans must remain
on construction site during
construction.

FLOOR NOTES: 0000

BOCA
PLAN REVIEW SECTION
Type of Occupancy: A-3
City of OKLAHOMA CITY
APPROVED THE PROVISIONS OF THE OKLAHOMA CITY BUILDING CODE
Checked by: [Signature] Date: 12/1/00

- SECTION 4 MASONRY
0470 FURNISH AND INSTALL GLASS BLOCKS TO LIMITS SHOWN.
SECTION 6 WOOD & PLASTICS
0601 INSTALL FULL HEIGHT PARTITION TO 4" ABOVE CEILING
W/ 3 5/8" WTL. STUD @ 24" O.C. MAX. W/ 1/2" CIP. BOTH SIDES.
FINISH TO MATCH EXISTING. NOTE: USE 6" WTL. STUDS, WHERE
INDICATED.
0602 INSTALL NEW HEADER PER DETAIL. SEE SHT. A3 FOR DETAIL.
0603 PATCH & SEAL OPENINGS TO MATCH ADJACENT CONSTRUCTION.
0604 ADD/EXTEND HALF WALL AS SHOWN, INCLUDE MARLITE & OAK CAP
TO MATCH EXISTING.
0607 LOWER SILL @ OPENING 6" DOWN. REINSTALL WOOD CAPS.
0611 ADD NEW MATCHING "B" GROOVE MORNING HAZE MARILITE TO MATCH
EXISTING.
0620 EXTEND PARAPET AT ENTRY TO NEW SPECS. AND CONSTRUCT NEW
PILASTERS AS INDICATED. SEE SHT. A4 FOR DETAILS.
0628 INSTALL NEW SALAD BAR TOP PROVIDED BY OWNER.
REPLACE PLANTS AT SNEEZEGUARD.
0629 REPAIR GAP @ MITER JOINT IN FRONT COUNTER BETWEEN MERCHANDISE AND REGISTERS.
0630 MOVE PICKUP SHELF BACK TO BE FLUSH W/ EXISTING WALL.
SECTION 8 DOORS & WINDOWS
0801 PROVIDE & INSTALL NEW ALUM. ENTRY DOORS, KAWNEER FRAME, & HARDWARE.
GLASS STOREFRONT ABV. SEE SHT. A4 FOR DETAILS. TRIM TO MATCH
ADJACENT CONSTRUCTION. SEE SHT. A2 FOR SPECIFICATIONS.
0802 PROVIDE & INSTALL NEW ALUM. VESTIBULE DOORS, FRAME, & HARDWARE.
KAWNEER SERIES 500 - WIDE STYLE, "PREMIER RED",
SEE SHT. A2 FOR SPECIFICATIONS.
0803 PROVIDE & INSTALL NEW SOLID CORE, LAMINATED COVERED DOOR &
HARDWARE. (LAMINATE MUST BE FACTORY INSTALLED WILSONART
HOLLYBERRY RED #0-307-76). SEE DOOR & HARDWARE SCHEDULE FOR
SPECS.
0804 REPLACE EXISTING DOOR & HARDWARE WITH SOLID CORE DOOR, & NEW
HARDWARE. SEE SHT. A2 DOOR AND HARDWARE SCHEDULES.
0805 FURNISH & INSTALL NEW "DARK BRONZE" ALUMINUM FRAMED WINDOWS
AS INDICATED. MATCH EXISTING. (ADA SHADED GLASS).
0806 FURNISH & INSTALL NEW ELIASON DOOR AND FRAME W/ WILSONART
HOLLYBERRY RED #0-307-76).
0809 PROVIDE & INSTALL (1) NEW HLM. DOOR W/ STL. FRAME AS INDICATED.
PAINT P-2 TYP., BOTH DOOR & FRAME. SEE SHT. A2 - DOOR AND
HARDWARE SCHEDULES FOR SPECS.
SECTION 9 FINISHES
0914 INSTALL NEW VINYL FLOORING, ARMSTRONG, PREMIUM EXCELON TILE
STONEDEX #52144 (COAL BLACK).
0961 PATCH IN NEW OWNER SUPPLIED CARPET & MASTIC AS INDICATED:
HARBINGER CARPET: "CEC PASSION" G/C TO FEATHER OUT EXISTING
SUB-FLOOR BEFORE INSTALLING NEW CARPET & G/C TO SUPPLY NEW
VINYL BASE, 4" BASE, BURKE #842P CHARCOAL.
0992 PATCH/PRIME AS REQUIRED AND PAINT FOR UPPER WALLS IN
AREAS INDICATED. SHERWIN WILLIAMS "LIGHT MOVES"
SW #1053 (PRIMAR-200 SEMI-GLOSS LATEX) PATCH TEXTURE TO MATCH EXIST.
FIRST COAT X-1-M 400-W PRIMER, SECOND COAT PRIMAR 200 LATEX SEMI
GLOSS ENAMEL, THIRD COAT PRIMAR 200 LATEX SEMI GLOSS ENAMEL.

- 0993 PATCH/PRIME AS REQUIRED AND PAINT INTERIOR DOOR FRAMES
WITH NEW RED FINISHED DOORS. SHERWIN WILLIAMS "WINDSOR
GRAY" SW #1040 (8-54 ALKID ENAMEL SEMI GLOSS)
0997 REPAIR & PAINT EXTERIOR @ NEW WINDOW LOCATIONS TYP. SEE SHT. A4.
0999 PAINT NEW EXTERIOR DRYMT @ NEW PILASTERS, PARAPET, AND OTHER
AREAS INDICATED NEW CUSTOM COLOR "DUSTER SHELL"
FORMULA: BASE-A-100 SATIN PAINT, B1-2+1, Y3-13, R2-1+01, N1-5.
SECTION 10 SPECIALTIES
1010 REINSTALL EXISTING (2) COSTUME HANGERS AS INDICATED.
1018 INSTALL NEW TECH ROOM BENCH & SHELVING, AS INDICATED.
SEE DETAIL/PLAN. RE: 01/A5 AND 16/A5.
1019 SUPPLY AND INSTALL NEW PLYWOOD AND 2 X 4 SHELVING.
1050 SIGN COMPANY TO INSTALL NEW BACKLIT SIGNING. G.C. TO
SUPPLY & CONNECT ELECTRICAL AS NEEDED. SEE SHT. A3.
1082 REPLACE ROPES AT KID CHECK W/ NEW LAW RED VELVET TYPE.
SIZE TO FIT CORRECTLY. FIELD VERIFY.
SECTION 11 EQUIPMENT
1103 RE-MOUNT EXISTING TELEPHONE CABINET PER ADA: COIN OPERATION &
CONTROLS @ 54" MAX. A.F.F. (FORWARD REACH, OR 4" SIDE REACH)
MOUNT SHELF SURFACE TO CLEAR 27" A.F.F.
SECTION 15 MECHANICAL
1517 RE-LOCATE 1/2" AIR LINE TO NEW LOCATIONS AS INDICATED. ATTACH
TO EXISTING AIR SYSTEM AS REQUIRED.
1518 LOCATE NEW 1/2" AIR LINE TO LOCATIONS AS INDICATED. ATTACH
TO EXISTING AIR SYSTEM AS REQUIRED.
SECTION 16 ELECTRICAL
1601 PROVIDE NEW DUPLEX FLOOR OUTLETS, TWO (2) OUTLETS PER
20 AMP. CIRCUIT. (FIELD VERIFY LOCATION AND QUANTITY)
TIE INTO EXISTING CIRCUITRY.
1602 PROVIDE NEW DUPLEX WALL OUTLETS AT 18" AFF THREE (3) OUTLETS
PER 20 AMP. CIRCUIT. (FIELD VERIFY LOCATION AND QUANTITY)
PLATES SHALL BE LEVITON #0703-EN, RECEPTACLES LEVITON #56250G.
TIE INTO EXISTING CIRCUITRY.
1606 EXISTING CONVENIENCE OUTLETS TO REMAIN, ADJUST HEIGHT
AT NEW WINDOWS AS REQUIRED.
1676 PROVIDE & INSTALL NEW 30 AMP FLOOR OUTLET AS INDICATED.
1678 RELOCATED ELECT. PANELS, "T1, T2, & T3".
RECONNECT TO EXISTING FEED.
1680 REPLACE LIGHT ON EXISTING POLE AT SIDE NEAR KITCHEN ENTRY W/
DOUBLE SHOE BOX UNIT & REPLACE DBL. THROW UNIT W/ 3-4 SHOE
BOX UNITS IN CENTER OF FRONT LOT.


LEGEND

=====	NEW CEILING HEIGHT PARTITIONS
=====	NEW DECK HEIGHT PARTITIONS W/ BATT INSULATION
=====	NEW HALF-WALLS HEIGHT PER PLANS & INTERIOR ELEVATIONS
=====	NEW HEADER
⊕	NEW WALL RECEPTABLES
⊙	NEW FLOOR RECEPTABLES

AIRLINE NOTES:

- 1/2" COPPER AIR LINE TO 1/8" THREAD WITH BALL VALVE DOWN TO SERVE EQUIPMENT.
TURN UP AS IT EXITS THE WALL, AND INSTALL @ 48" AFF. WITH PRESSURE REGULATOR,
GAUGE, FLEXIBLE YELLOW COIL AIR LINE AND "NOZ-LA" BALLOON AS MANUFACTURED
BY WINDY BALLOON CORP. (1-800-421-1980) AND FURNISHED BY GEN'L CONTRACTOR.
- 1/2" COPPER AIR LINE TO 1/4" THREAD WITH BALL VALVE DOWN TO SERVE EQUIPMENT.
INSTALL @ 8" ABV. COUNTERTOP.
- 1/2" COPPER AIR LINE TO 1/2" BALL VALVE TO TERMINATE @ 3/8" QUICK DISCONNECT
FEMALE. TERMINATE @ SIDE WALL, 48" A.F.F. WITH OWNER FURNISHED REGULATOR.
- SEE SHT. E3 FOR LOCATIONS.

ALL ELECTRICAL, PLUMBING, HEAT AND
AIR, FENCE, SIGN, SIDEWALK, AND DRIVEWAY
CONSTRUCTION SHALL BE PERFORMED BY
A LICENSED AND BONDED CONTRACTOR
AND SHALL CONFORM TO THE RESPECTIVE
CODE REQUIREMENTS FOR EACH.

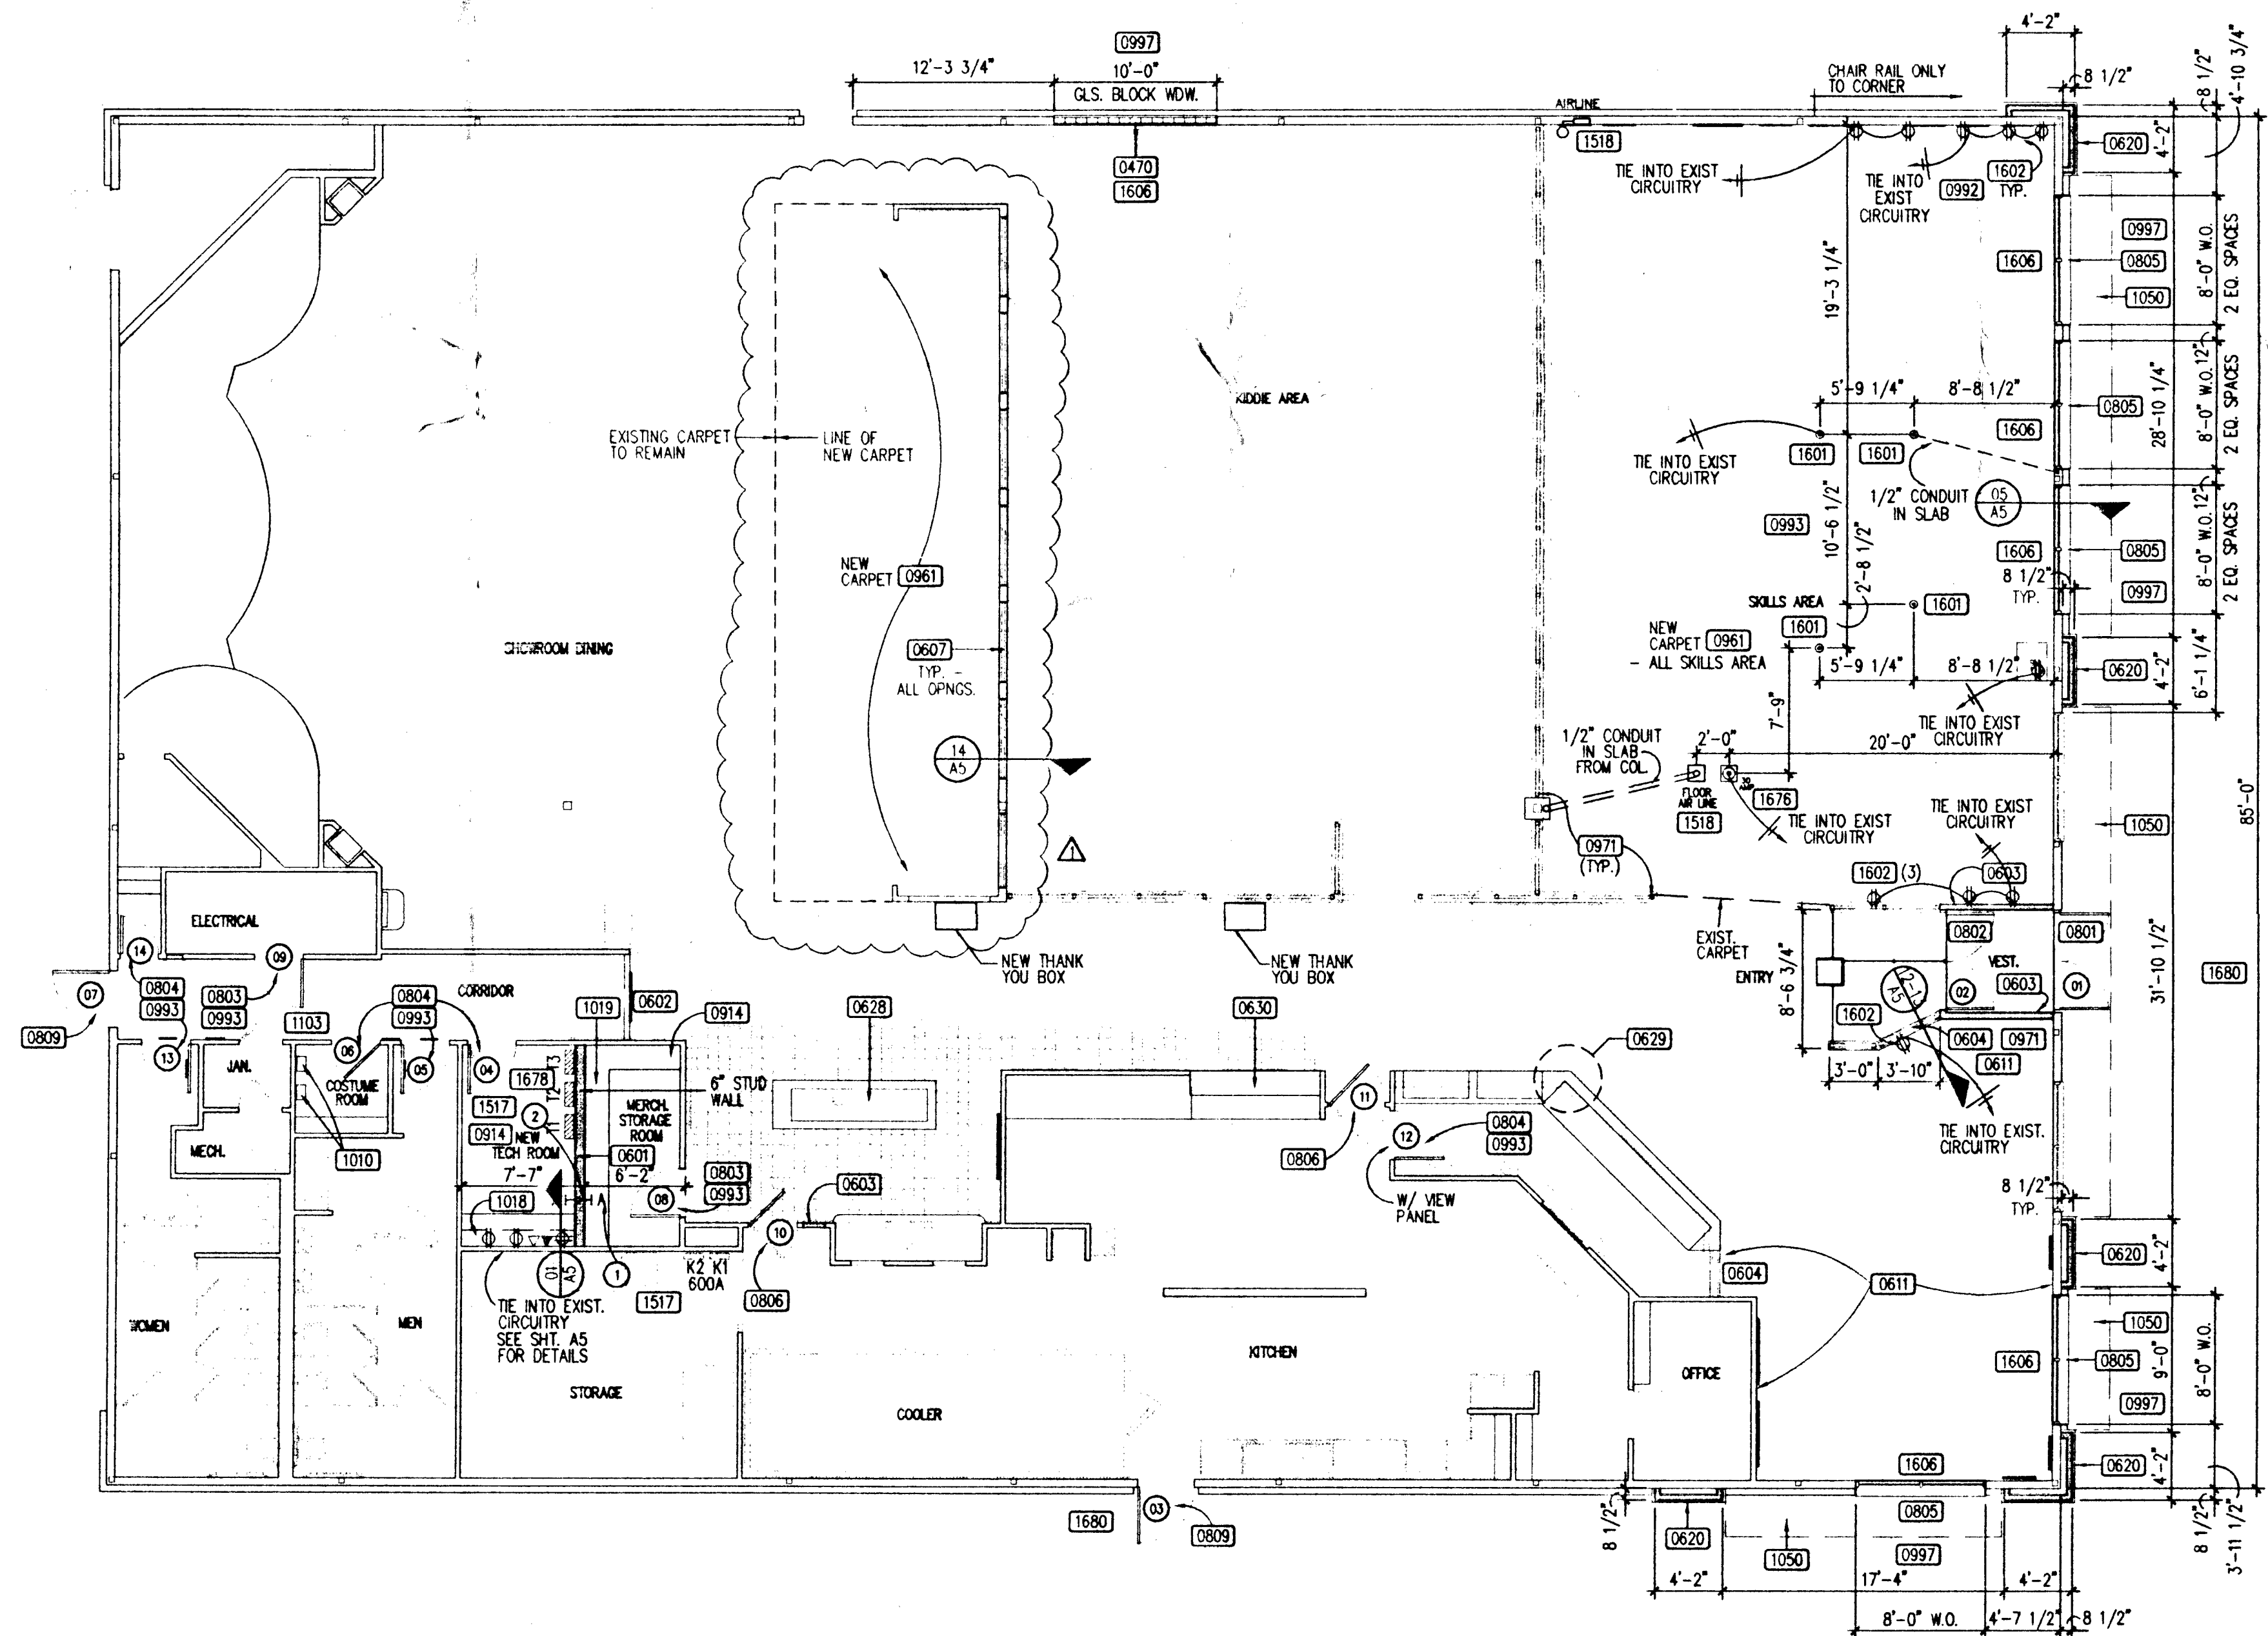

01 FLOOR PLAN
SCALE: 1/8" = 1'-0"

CHUCK E. CHEESE'S PIZZA. #889
8817 N. W. EXPRESSWAY
OKLAHOMA CITY, OK 73132
C. E. C. ENTERTAINMENT, INC.
4441 WEST AIRPORT FREEWAY
IRVING, TEXAS 75062

OKLAHOMA CITY, OK


FLOOR PLAN

Date: 03/28/00

Revisions:
Δ REVISIONS 06/16/2000
CITY COMMENTS


Project Number: SB-889

Sheet Number: A1 of 8

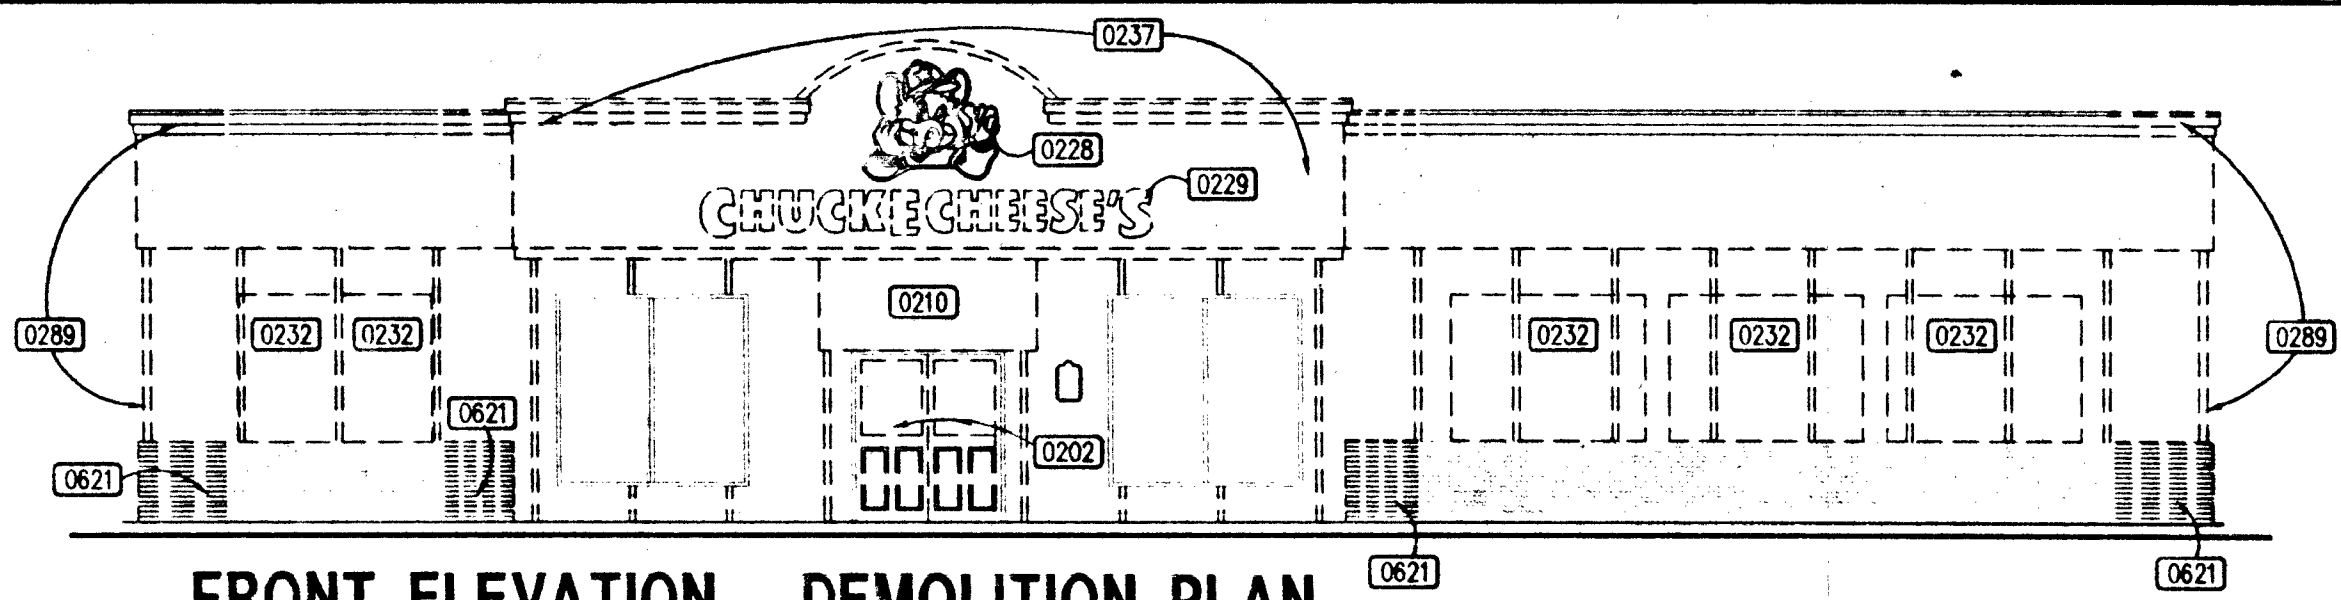


01 FRONT ELEVATION - DEMOLITION PLAN

SCALE: 1/8" = 1'-0"

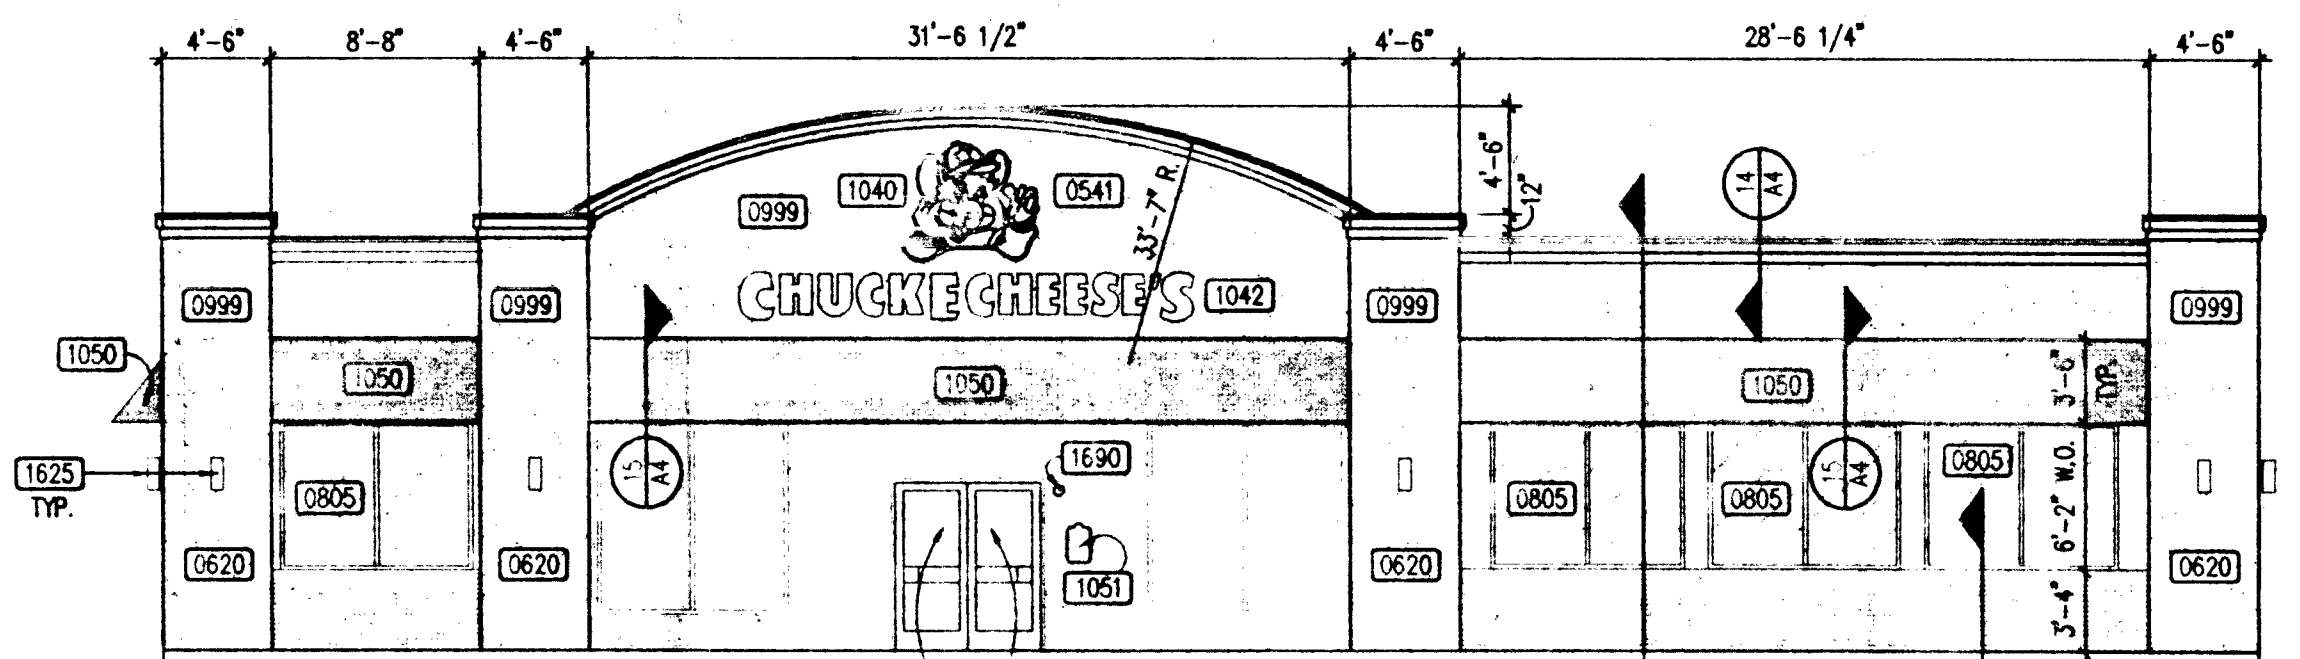


03 FRONT ELEVATION

SCALE: 1/8" = 1'-0"

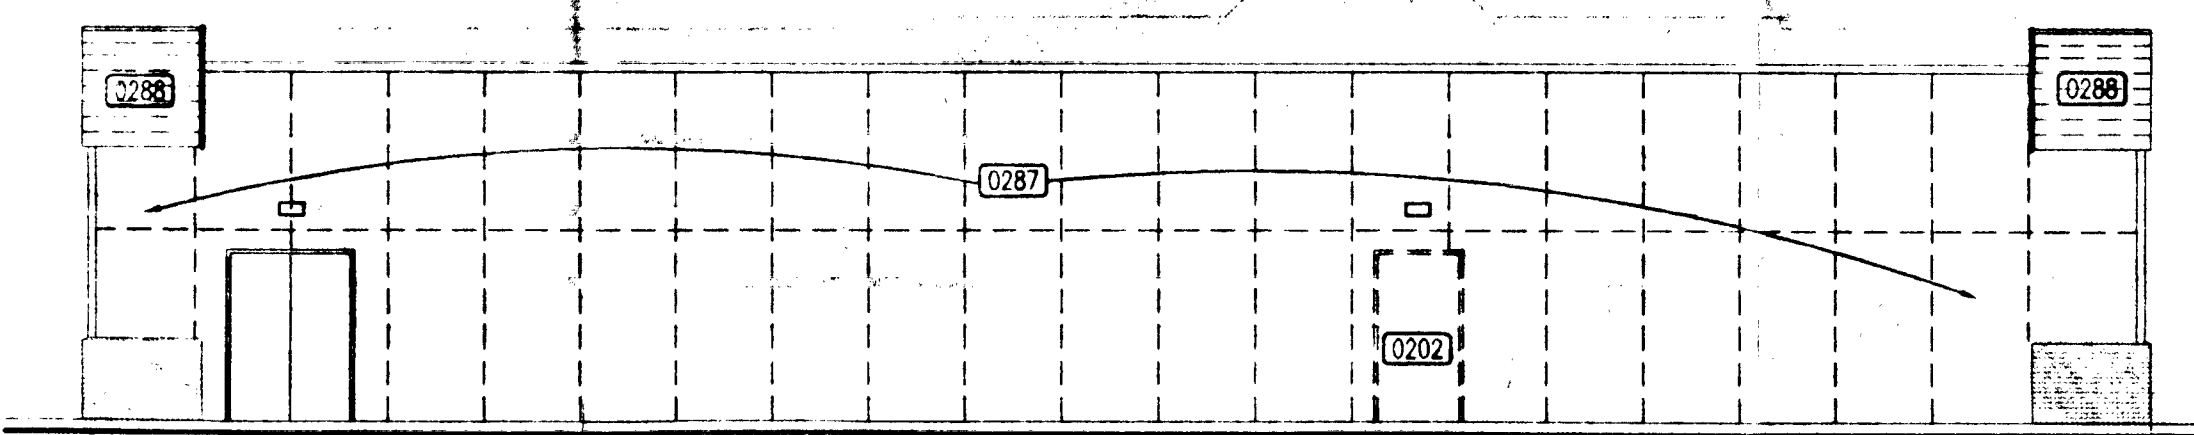


05 REAR ELEVATION - DEMOLITION PLAN

SCALE: 1/8" = 1'-0"

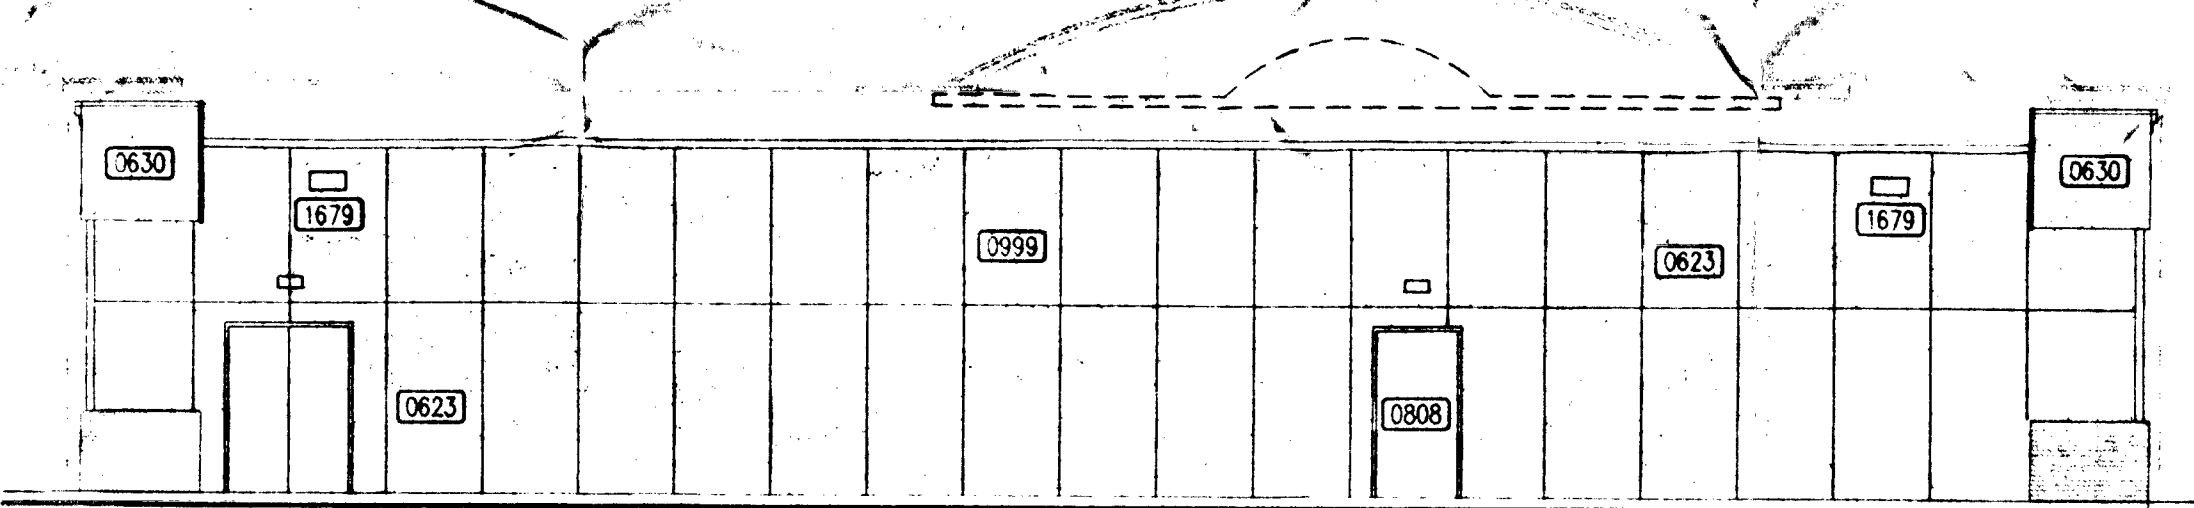


07 REAR ELEVATION

SCALE: 1/8" = 1'-0"

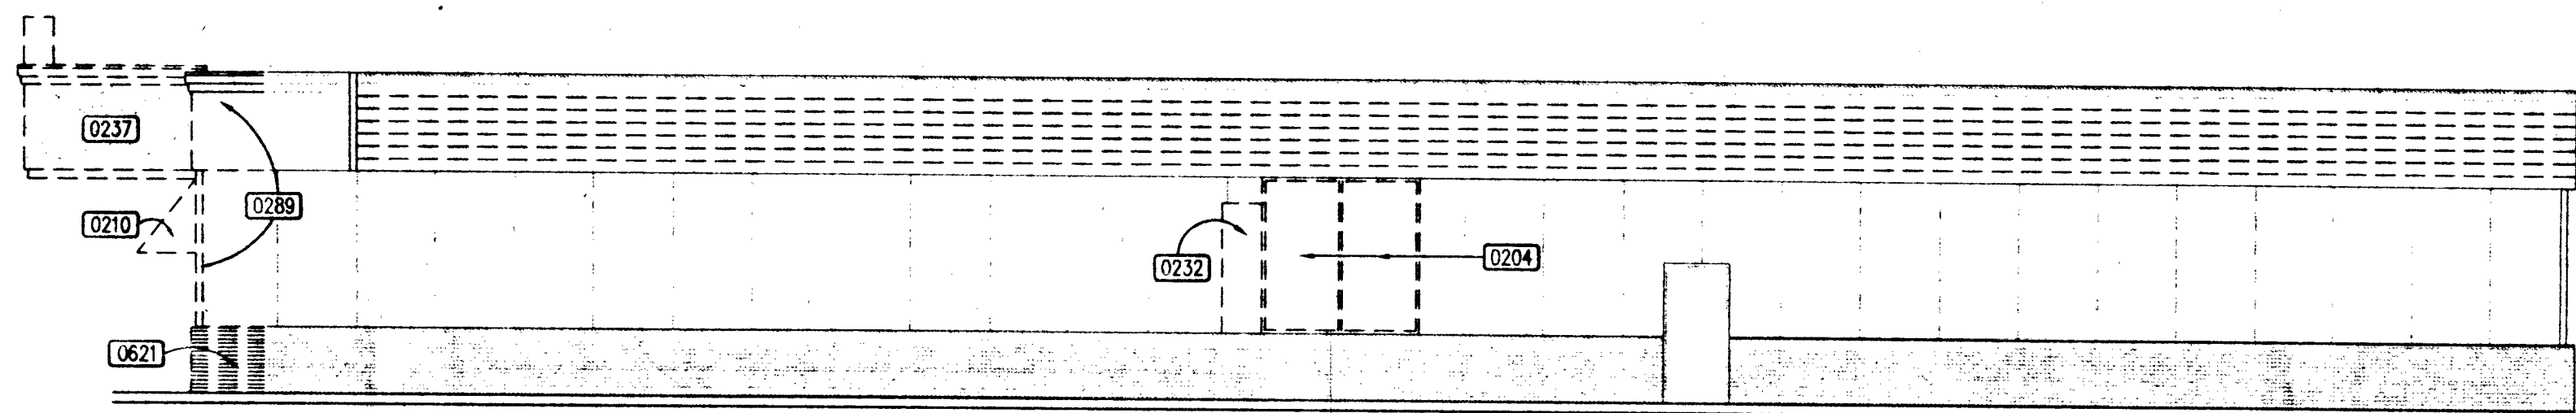


02 RIGHT ELEVATION-DEMOLITION

SCALE: 1/8" = 1'-0"

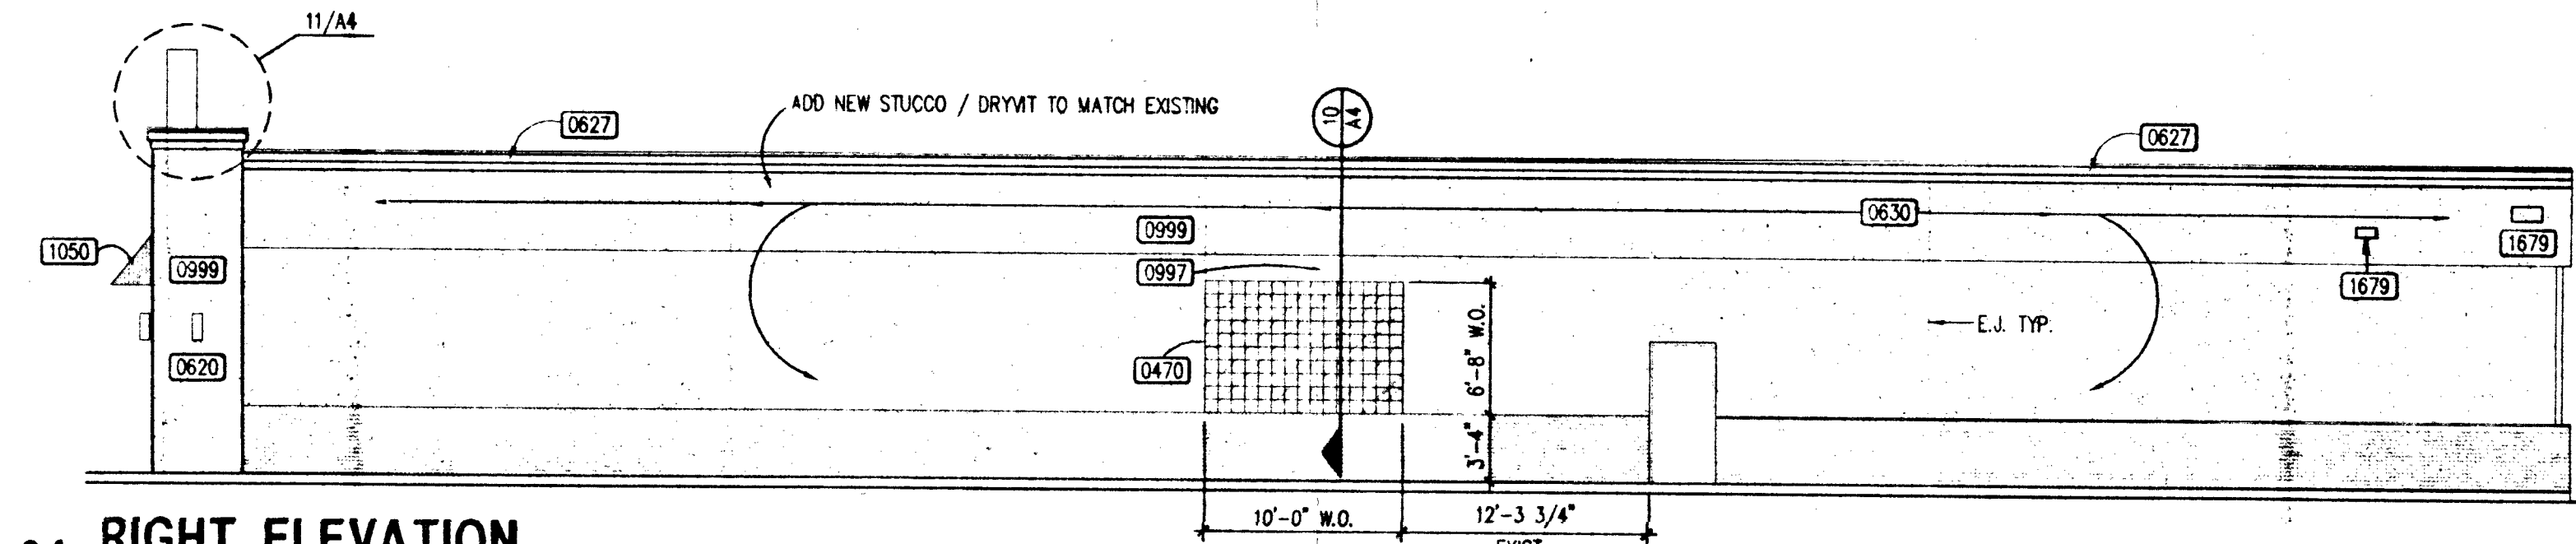


04 RIGHT ELEVATION

SCALE: 1/8" = 1'-0"

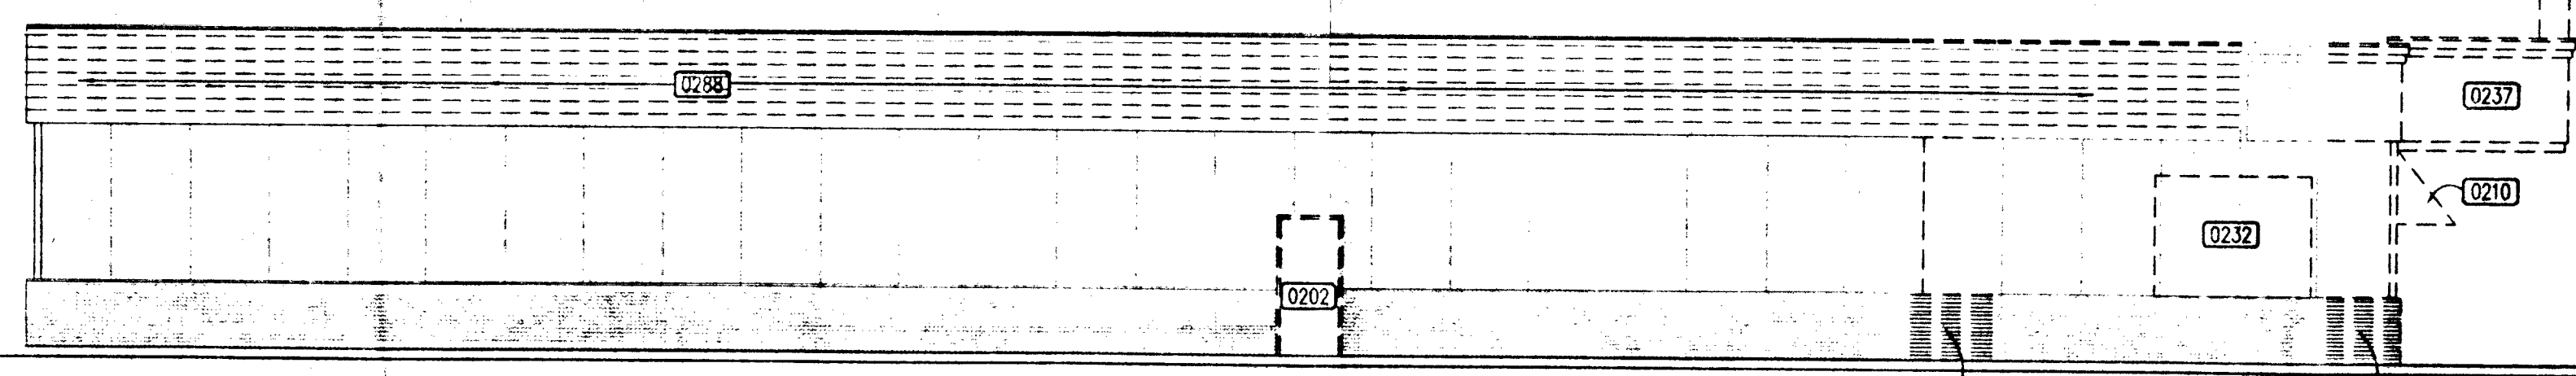


06 LEFT ELEVATION - DEMOLITION PLAN

SCALE: 1/8" = 1'-0"

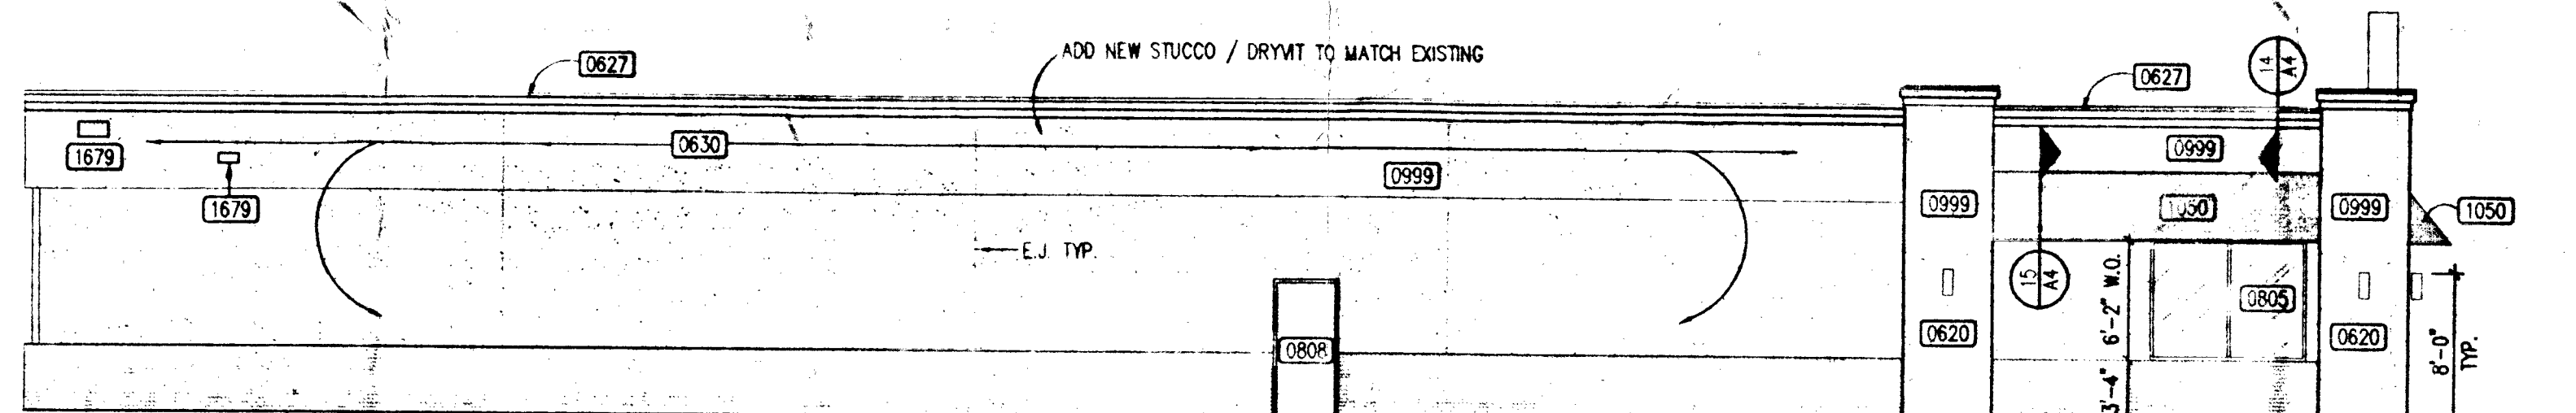


08 LEFT ELEVATION

SCALE: 1/8" = 1'-0"

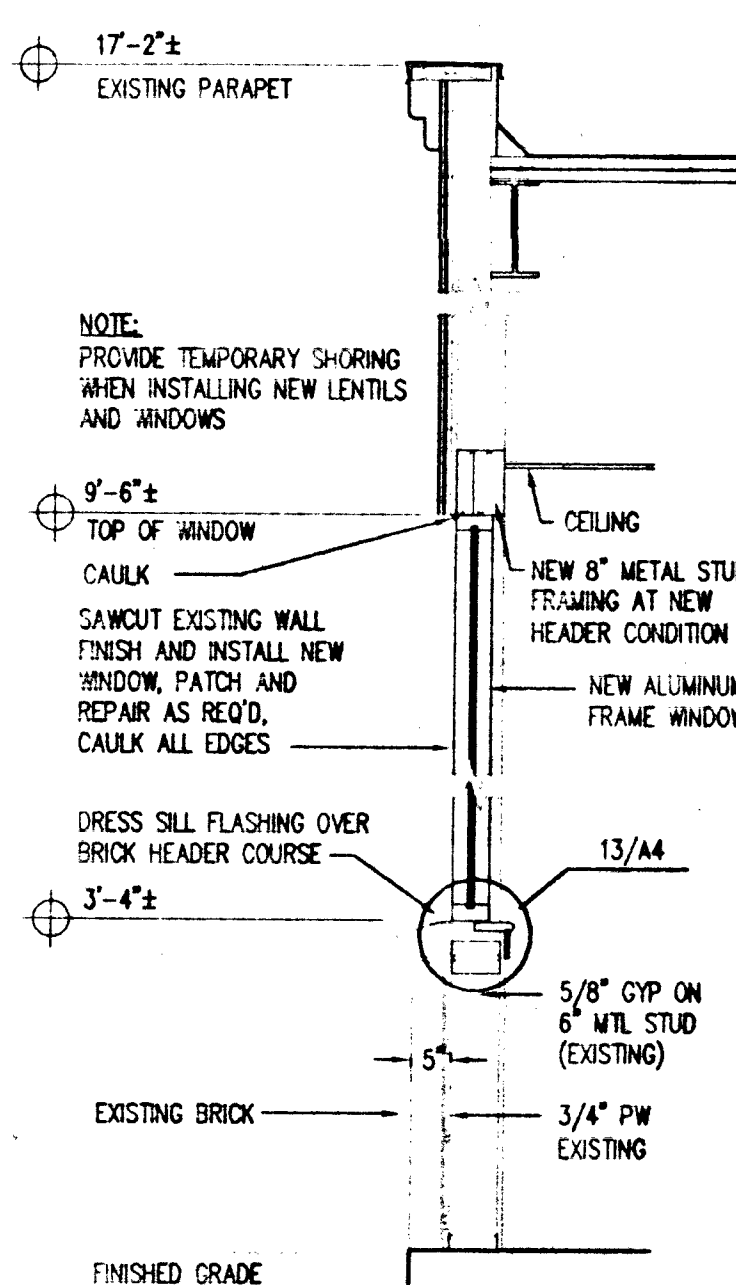


09 WALL SECTION @ STOREFRONT WINDOW

SCALE: 1/2" = 1'-0"

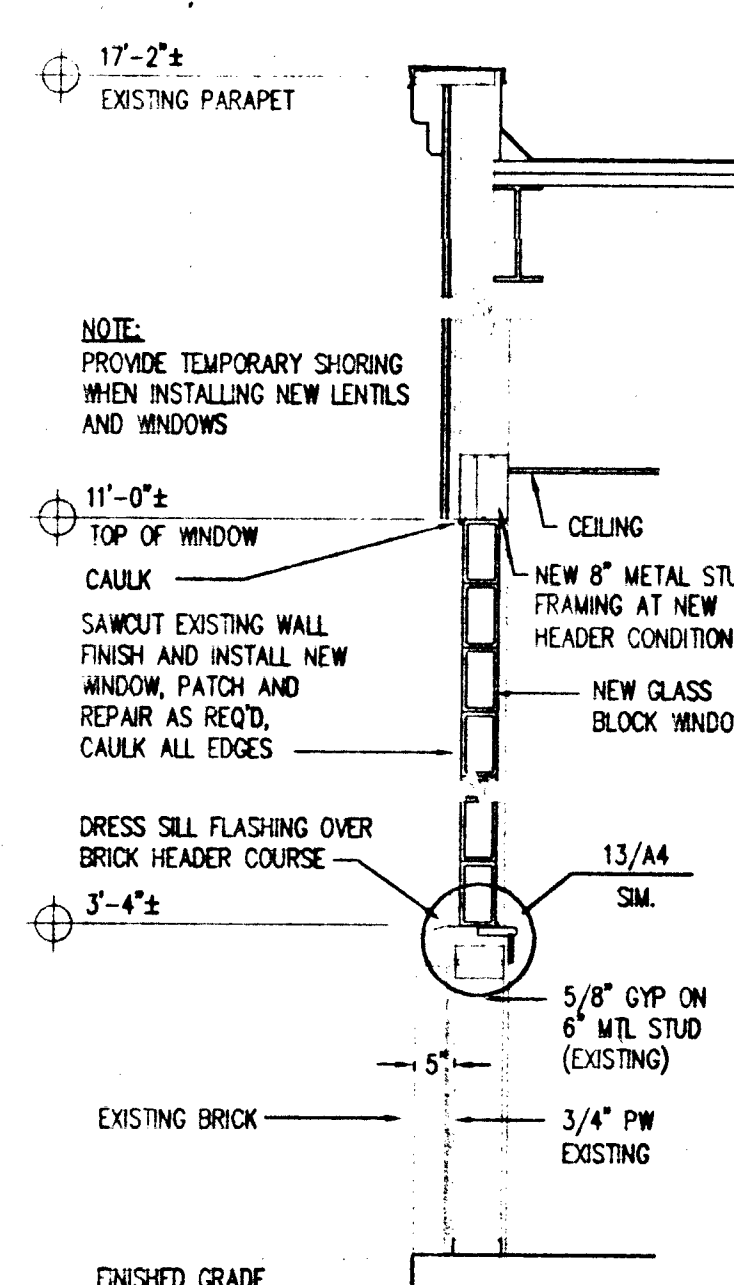


10 WALL SECTION @ GLASS BLK. WINDOW

SCALE: 1/2" = 1'-0"

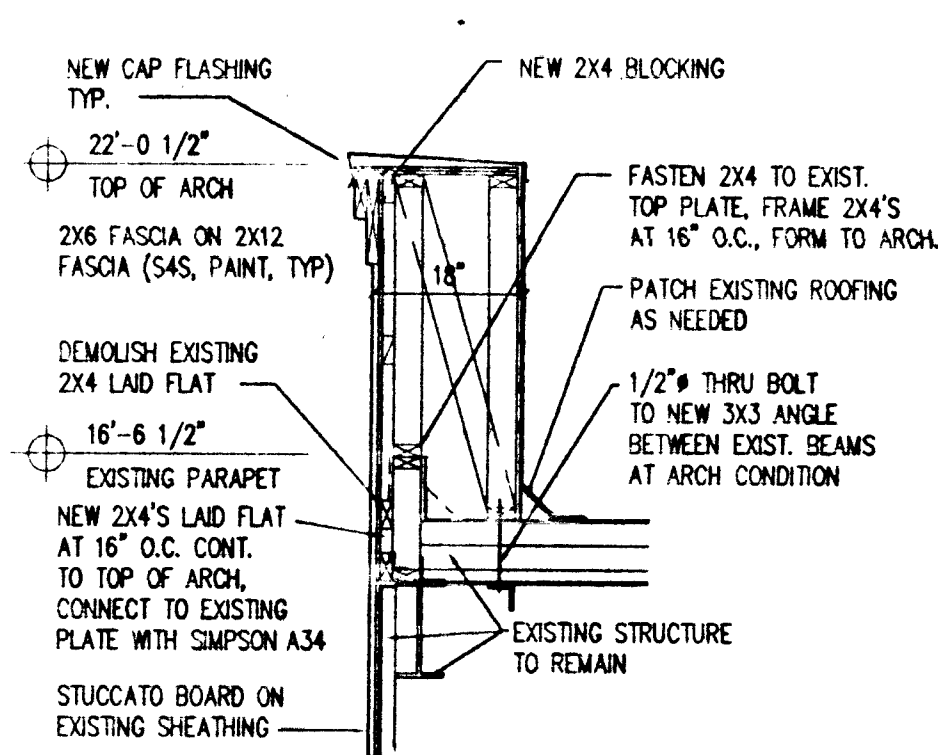


11 ARCH DETAIL

SCALE: 1/2" = 1'-0"

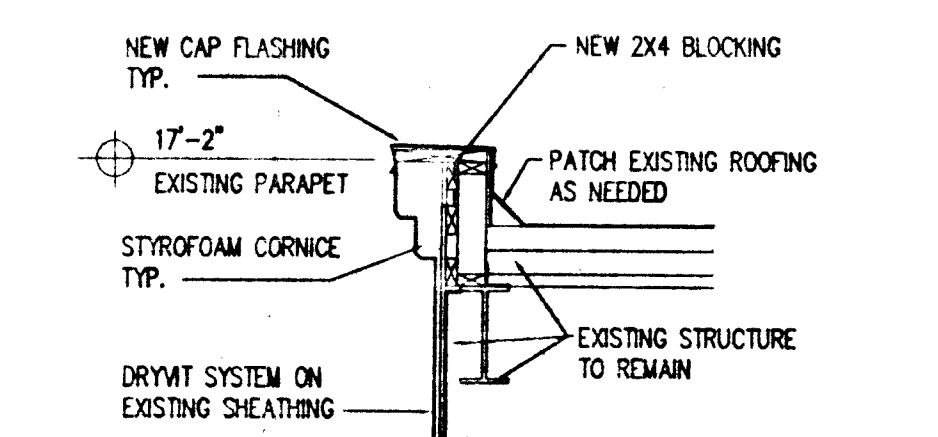


14 CORNICE DETAIL

SCALE: 1/2" = 1'-0"

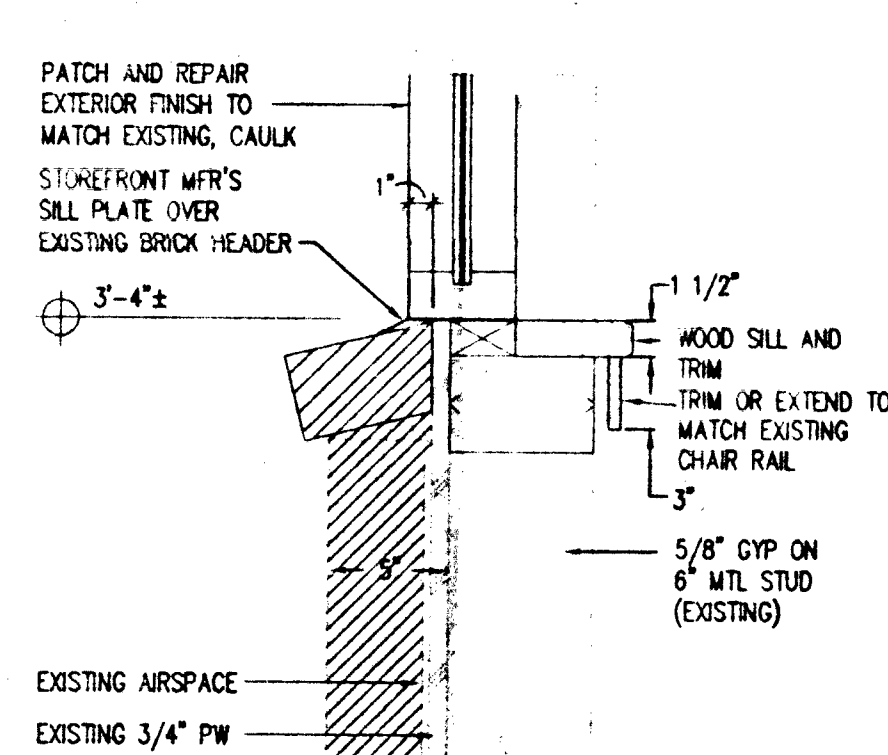


12 WINDOW SILL

SCALE: 3" = 1'-0"

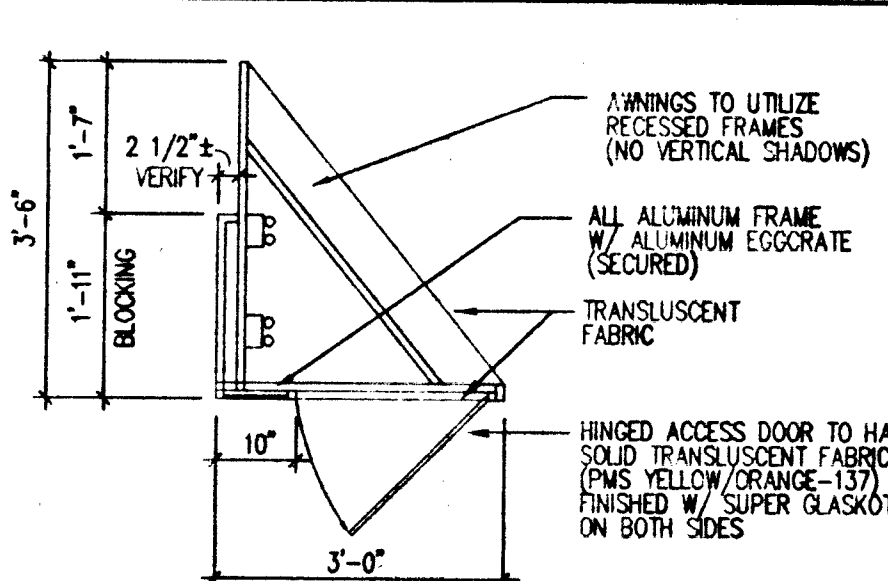

15 TYPICAL AWNING DETAIL

SCALE: 1/2" = 1'-0"

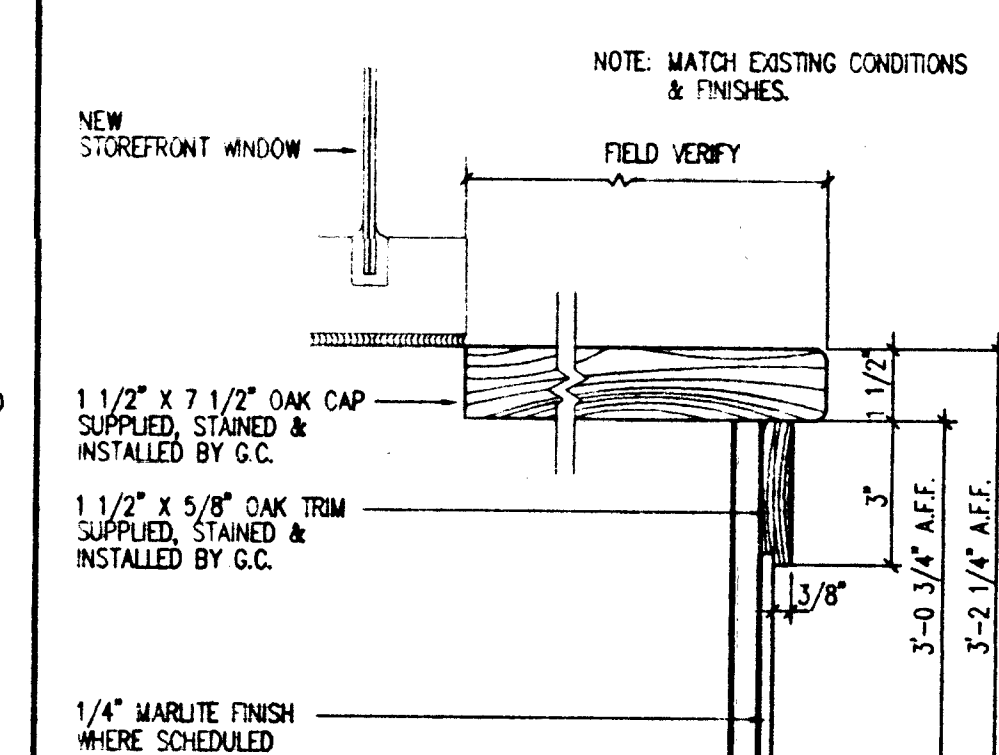


13 OAK CAP DETAIL AT WINDOW

SCALE: 3" = 1'-0"

NOTES: 0000

- SECTION 2 DEMOLITION/STICWORK/REMOVAL
- 0202 REMOVE EXISTING DOORS, FRAME(S), & HARDWARE. PREPARE FOR NEW DOOR INSTALLATION.
- 0204 REMOVE EXISTING WINDOW. PATCH & REPAIR FOR NEW WORK.
- 0210 SIGN CO. TO REMOVE EXIST. AWNING. PATCH & REPAIR FOR NEW WORK.
- 0228 SIGN COMPANY TO REMOVE EXIST. LOGO, SAVE FOR REINSTALLATION.
- 0229 SIGN COMPANY TO REMOVE EXISTING CHANNEL LETTERS.
- 0232 REMOVE PORTIONS OF WALL TO LIMITS SHOWN.
- 0237 DEMO EXISTING ENTRY CANOPY.
- 0283 REMOVE (5) EXISTING ROOF MOUNTED BUILDING LIGHTS.
- 0284 REMOVE EXISTING HALIDE LT. FIXTURES. FIELD VERIFY QUANTITY.
- 0287 REMOVE EXIST. STUCCATO BOARD. REPLACE AS SHOWN.
- 0288 REMOVE EXIST. WOOD BAND AS INDICATED. REPLACE AS SHOWN.
- 0289 REMOVE EXIST. VERTICAL WOOD TRIM & CORNICE AS REQUIRED FOR INSTALLATION OF NEW AWNING PARAPET & PYLASTERS.
- SECTION 4 MASONRY
- 0470 FURNISH AND INSTALL GLASS BLOCKS TO LIMITS SHOWN.
- SECTION 5 METAL
- 0541 EXTEND PARAPET TO LIMITS SHOWN, FRAME PER DETAIL & FINISH WITH MATCHING METAL FASCIA.
- SECTION 6 WOOD & PLASTICS
- 0620 CONSTRUCT NEW PYLASTERS AS SHOWN. PAINT AS INDICATED.
- 0621 SAWCUT EXISTING BRICK. HANGCUT TO FIT NEW PYLASTERS AS REQUIRED. SEE CUT DMS ON SHT. D1.
- 0623 REPLACE WOOD UPPER BAND & EXISTING STUCCATO BOARD @ LOWER HALF W/ NEW FULL STUCCATO BOARD. ADD NEW WOOD CORNICE AS INDICATED. PAINT AS INDICATED. NOTE: FULL STUCCATO BOARD @ REAR AS INDICATED.
- 0627 INSTALL NEW PARAPET CORNICE TRIM AS INDICATED. SEE DTL 14/A4.
- 0630 INSTALL NEW STUCCO/DRYBAT TO WALLS AS INDICATED.
- SECTION 8 DOORS & WINDOWS
- 0801 PROVIDE & INSTALL NEW ALUM. ENTRY DOORS, FRAME, & HARDWARE. SEE SHT. A2 FOR SPECIFICATIONS.
- 0808 PROVIDE & INSTALL NEW HOLLOW CORE METAL DOORS, FRAME, & HARDWARE. SEE SHT. A2 FOR SPECIFICATIONS.
- SECTION 9 FINISHES
- 0997 PATCH, REPAIR & PAINT EXTERIOR @ NEW WINDOW LOCATIONS TYP. TO MATCH EXISTING FINISHES. PAINT AS INDICATED.
- 0999 PAINT NEW EXTERIOR DRYBAT @ NEW PYLASTERS, PARAPET, AND OTHER AREAS INDICATED NEW CUSTOM COLOR "OYSTER SHELL" FORMULA: BASE-A-100 SATIN PAINT, B1-241, V3-13, R2-14-01, M-5.
- SECTION 10 SPECIALTIES
- 1040 SIGN COMPANY TO REINSTALL 5' THINBROCK LOGO SIGN. ADJUST POWER AS REQUIRED.
- 1042 SIGN COMPANY TO REINSTALL 24" LETTER SIGN. ADJUST POWER AS REQUIRED.
- 1050 SIGN COMPANY TO INSTALL NEW BACKLIT AWNING. G.C. TO SUPPLY & CONNECT ELECTRICAL AS NEEDED.
- 1051 SIGN COMPANY TO INSTALL NEW HOURS OF OPERATION SIGN.
- SECTION 16 ELECTRICAL
- 1625 INSTALL NEW EXTERIOR WALL SCONCES AS INDICATED. MOUNT W/TOP AT 8'-0" HT. G.C. TO COORDINATE ELECTRICAL AS NEEDED. SEE SCHEDULE FOR DETAILS.
- 1679 PROVIDE & INSTALL (4) NEW WTL. HALIDE FIXTURES AS INDICATED. SEE SCHEDULE FOR DETAILS.
- 1690 EXISTING DOOR BELL TO REMAIN.

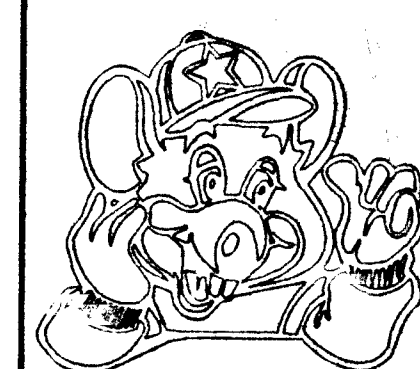


ARCHITECTURE - PLANNING - DESIGN
C.T. CHANG - AIA
1010 EULESS BOULEVARD, SUITE 110
EULESS, TX 76040
817 564-8010

CHUCK E. CHEESE'S PIZZA. #889
8817 N. W. EXPRESSWAY
OKLAHOMA CITY, OK 73122
C. E. ENTERTAINMENT, INC.
4441 WEST AIRPORT FREEWAY
IRVING, TEXAS 75062

OKLAHOMA CITY, OK

EXTERIOR ELEVATIONS AND DETAILS

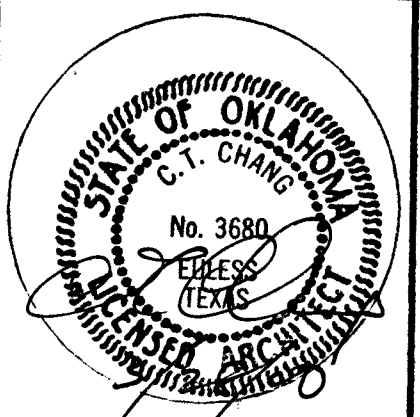

Date
03/28/00


Revisions

Project Number
SB-889


Sheet Number
A4

of 8


THESE DOCUMENTS ARE THE SOLE PROPERTY OF CEC. ENTERTAINMENT, INC. ANY COPYING OR USE OF THESE DOCUMENTS FOR ANY PURPOSE OTHER THAN CONSTRUCTION OF THIS PROJECT WITHOUT EXPRESSED WRITTEN PERMISSION OF THE ARCHITECT AND CEC ENTERTAINMENT, INC. IS PROHIBITED.

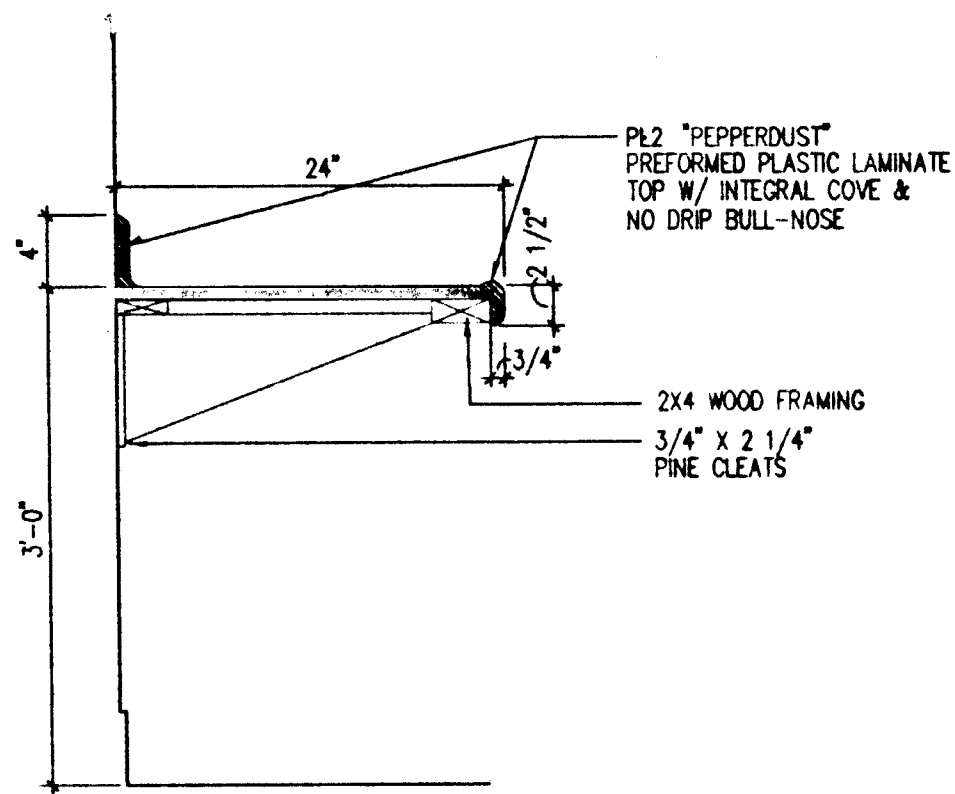


**01 OFFICE OR
TECH ROOM COUNTER**
N.T.S.

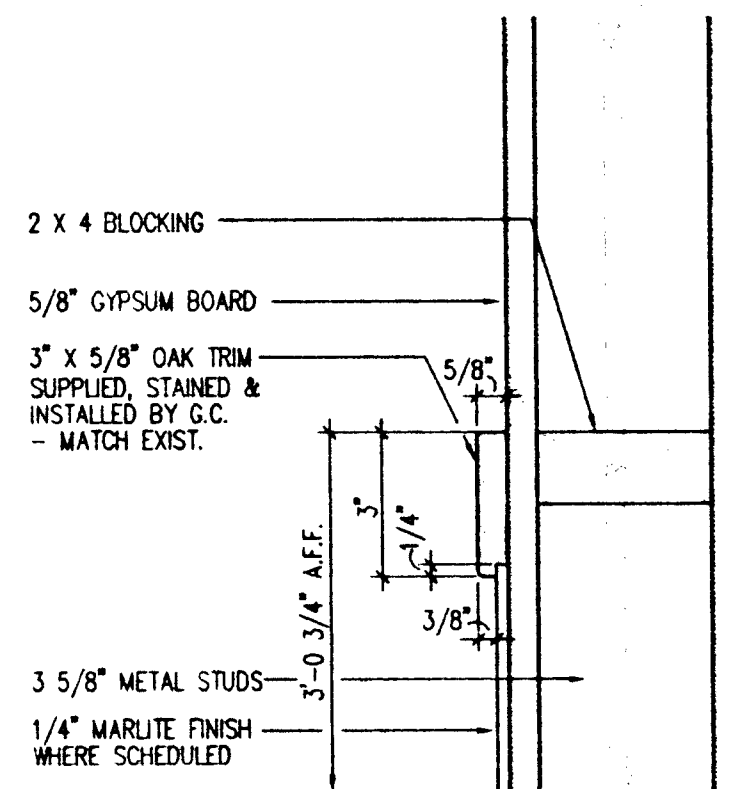


02 CHAIR RAIL
SCALE: 3\"/>

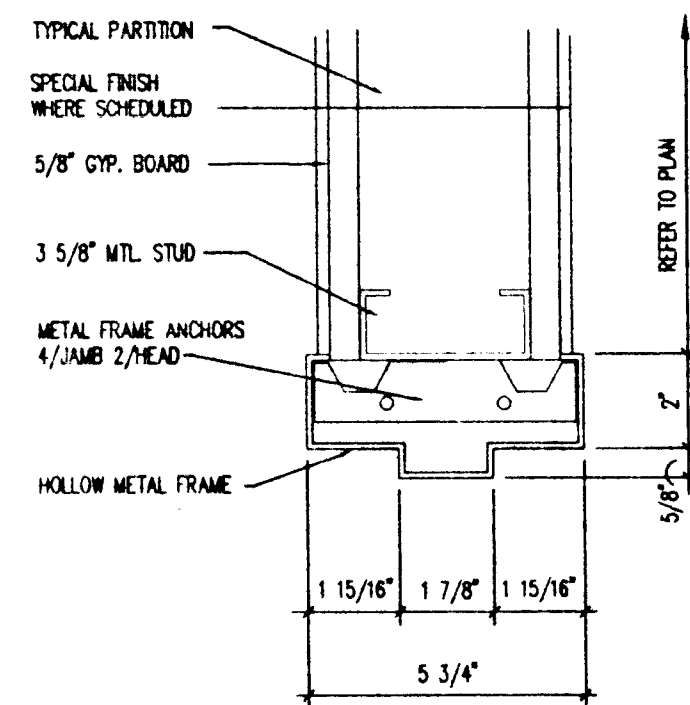


03 INTERIOR DOOR HEAD/JAMB
NO SCALE

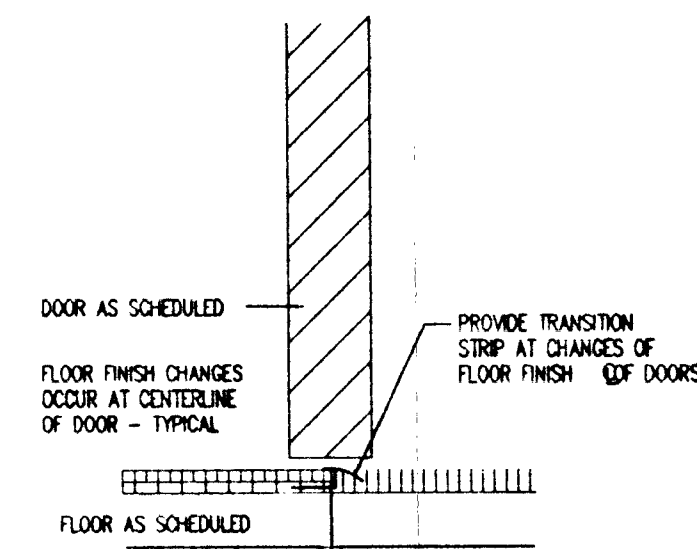


04 INTERIOR DOOR THRESHOLD
NO SCALE

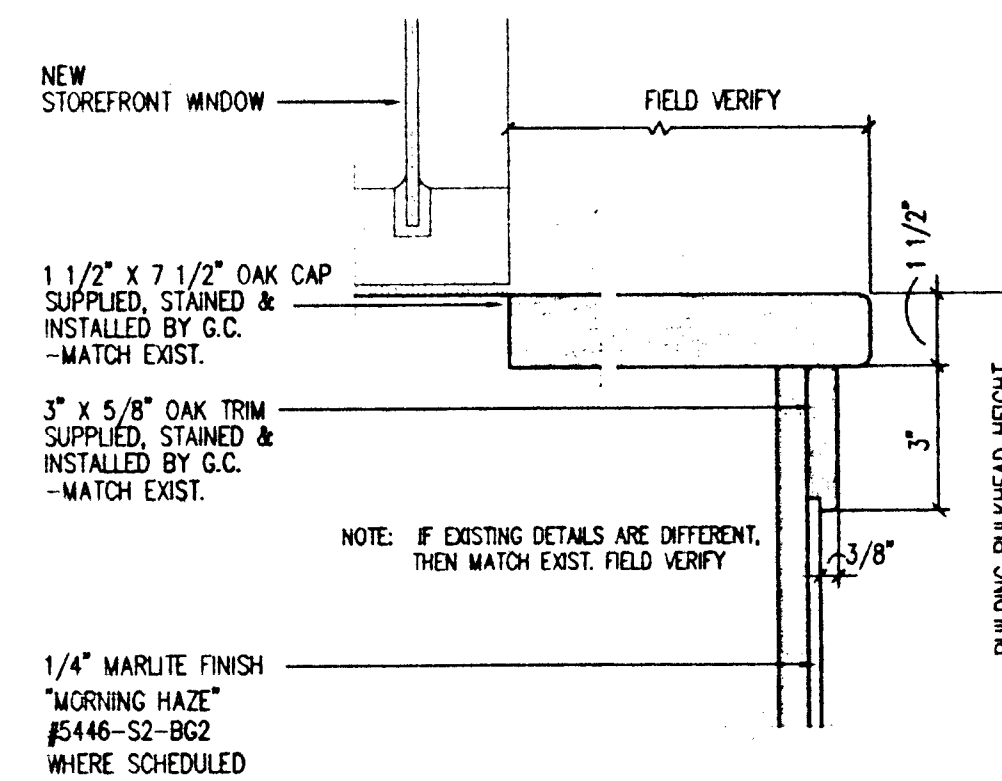


05 OAK CAP DETAIL AT WINDOW
SCALE: 3\"/>

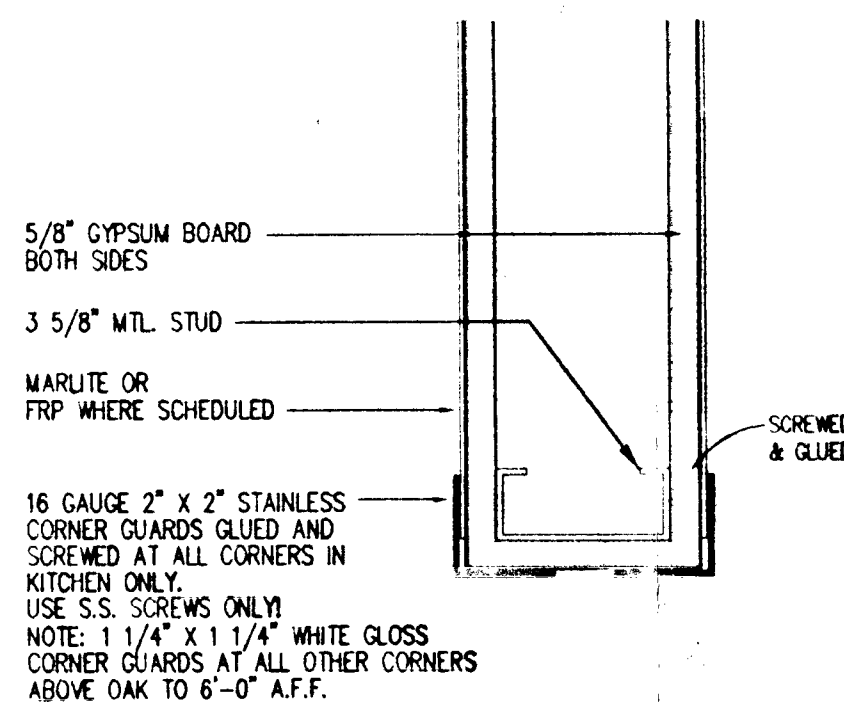

06 NOT USED
SCALE: 0

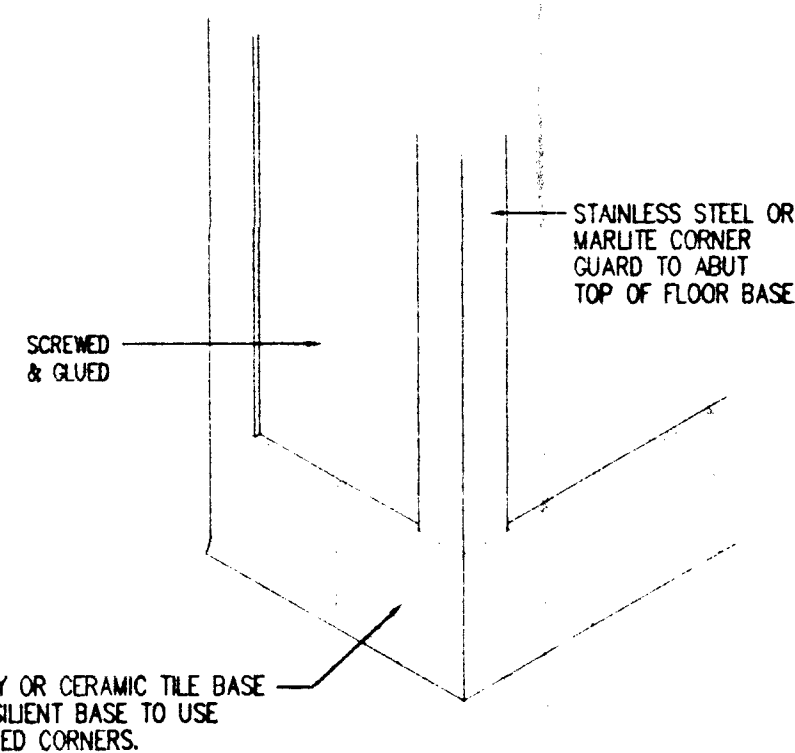


07 CORNER GUARD
SCALE: 3\"/>

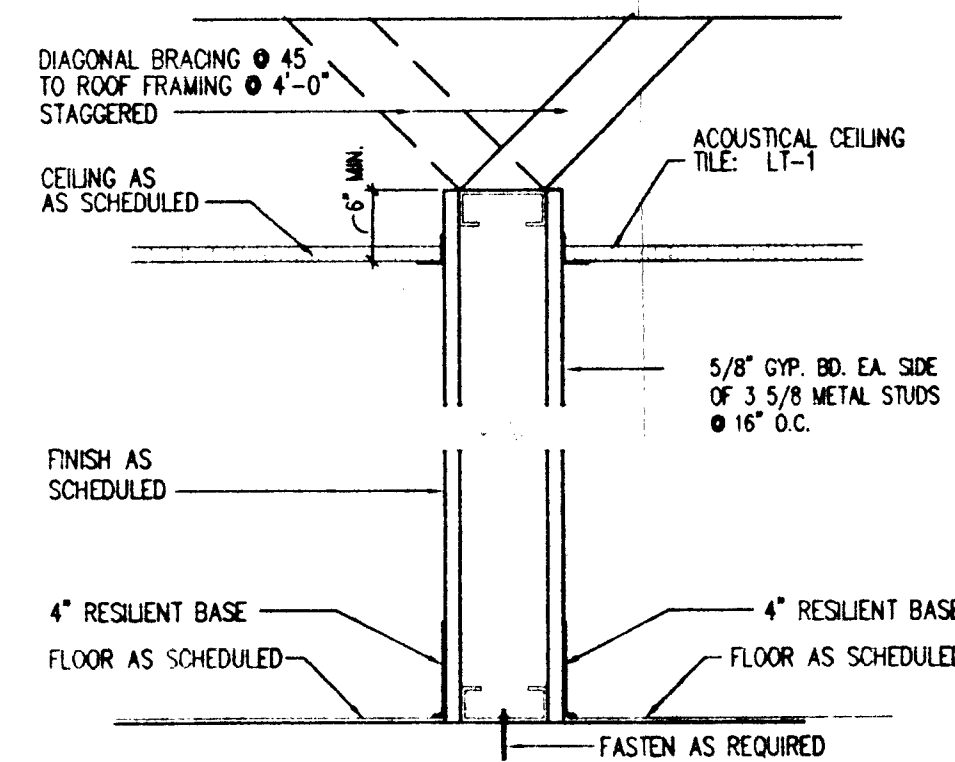


08 CORNER DETAIL
SCALE: 1 1/2\"/>


09 TYPICAL INTERIOR PARTITION
SCALE: 3\"/>

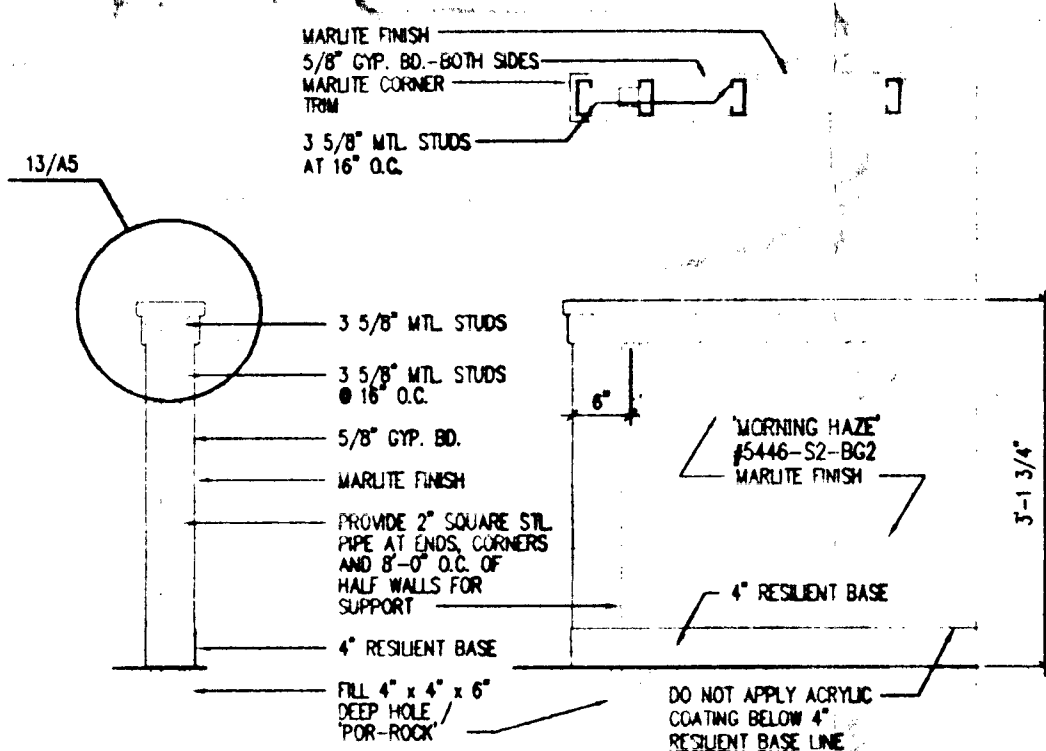

10 NOT USED
SCALE: 0

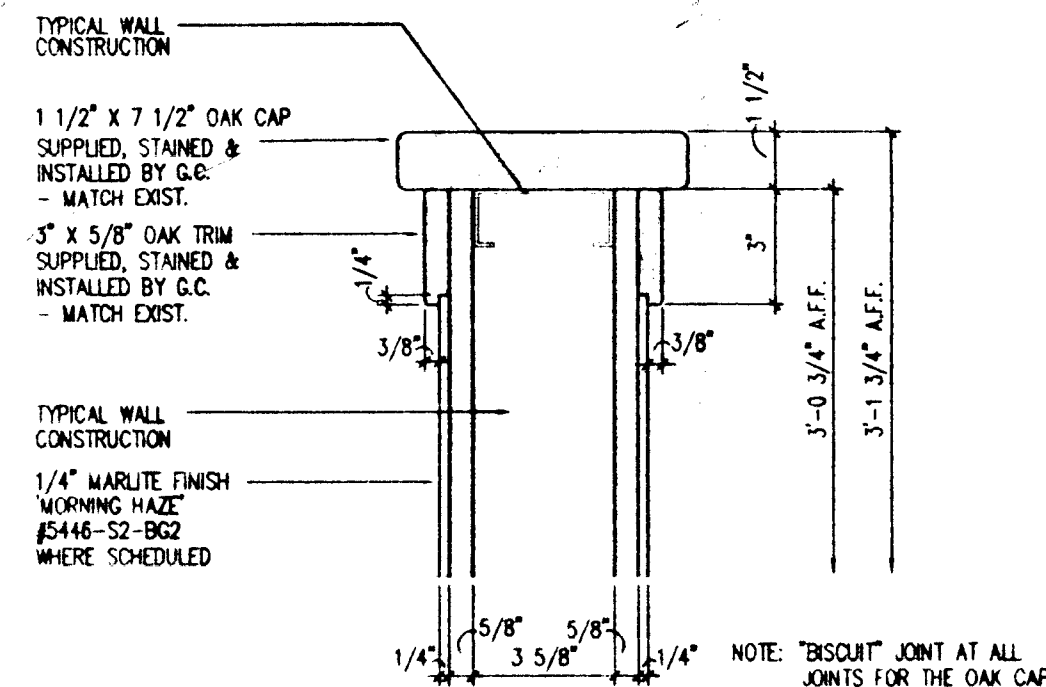


11 NOT USED
SCALE: 0

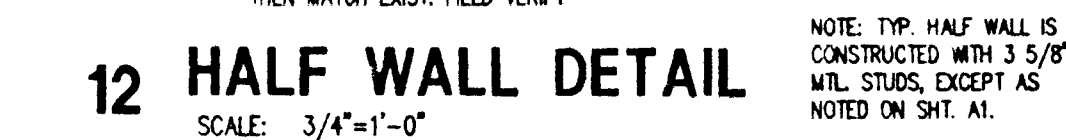


12 HALF WALL DETAIL
SCALE: 3/4\"/>



13 OAK CAP AT HALF WALL
SCALE: 3\"/>

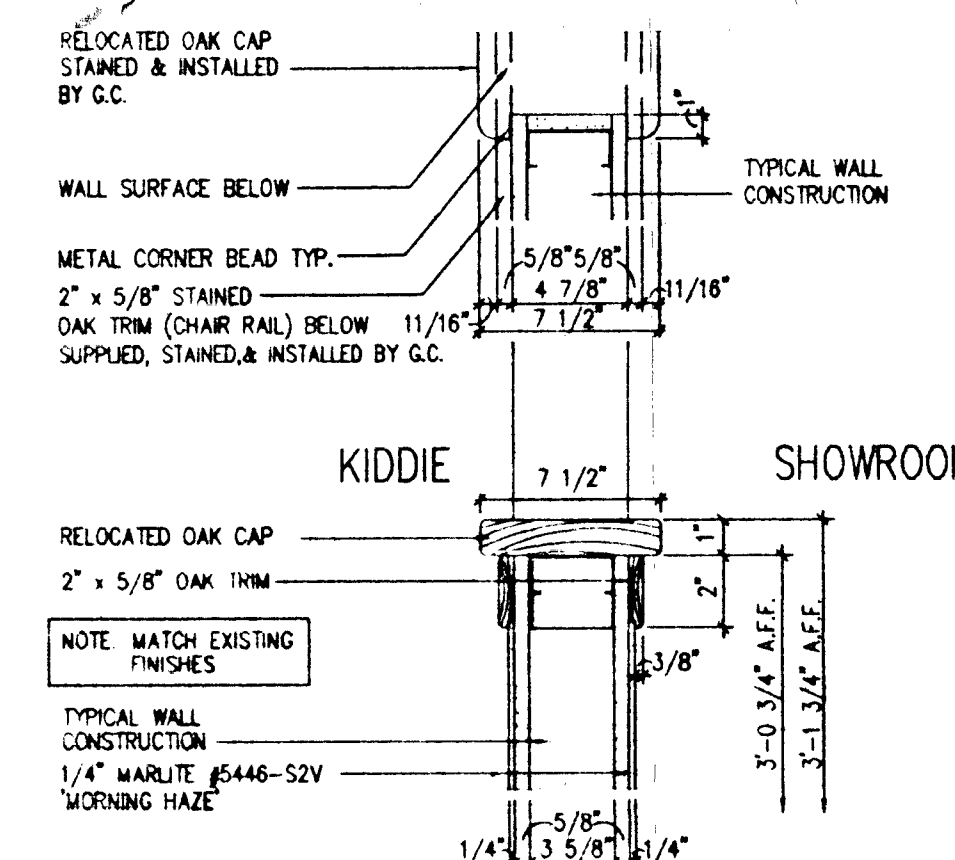

14 SECTION @ SHOWROOM OPNG.
NO SCALE

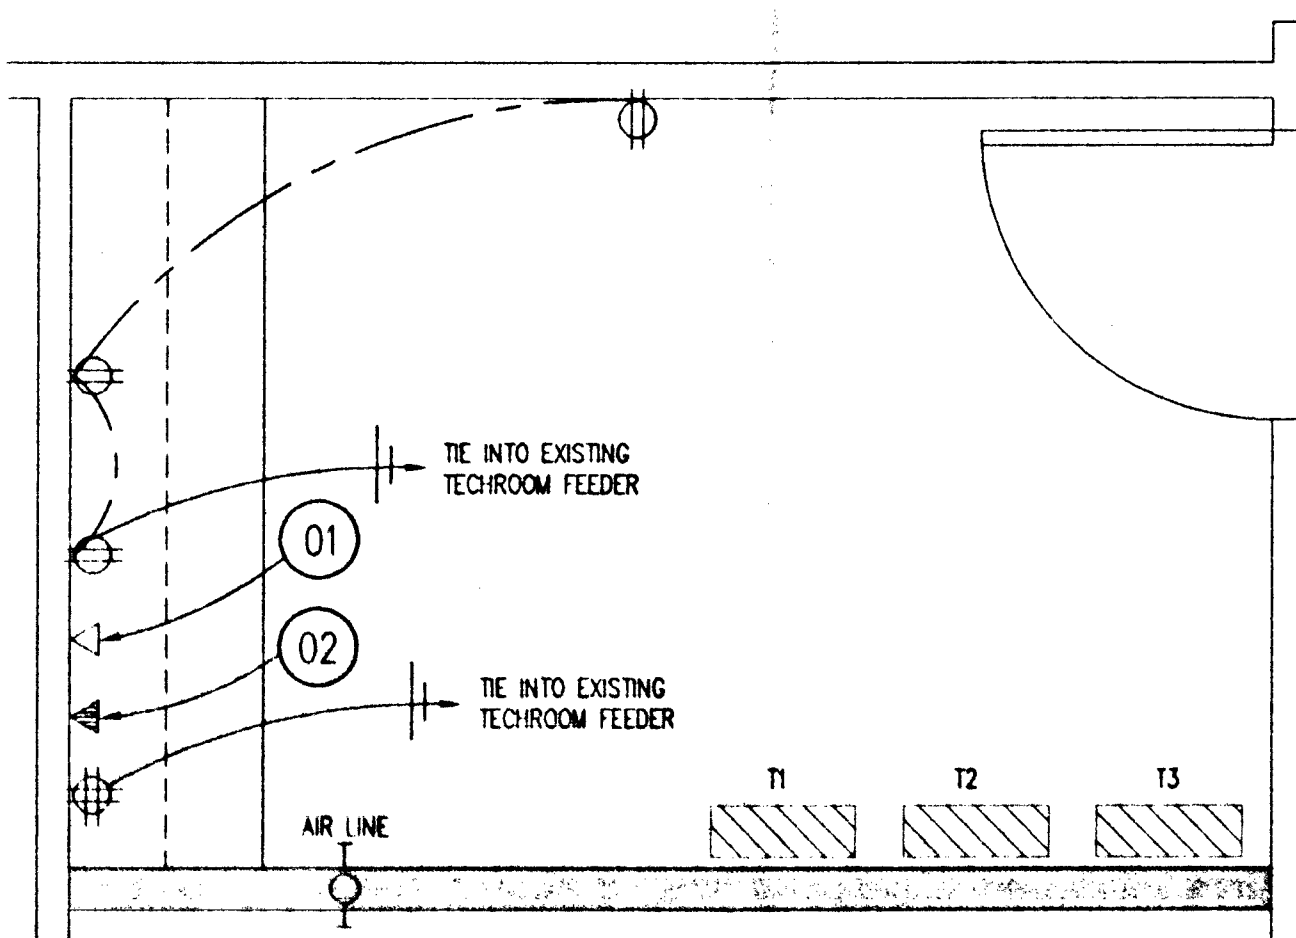


15 TECH ROOM PLAN AND ELECTRICAL
N.T.S.

TECH ROOM NOTES

- (01) ANALOG DEDICATED PHONE OUTLET FOR CASH REG. & COMPUTERS.
- (02) PHONE OUTLET


16 NOT USED
SCALE: 0

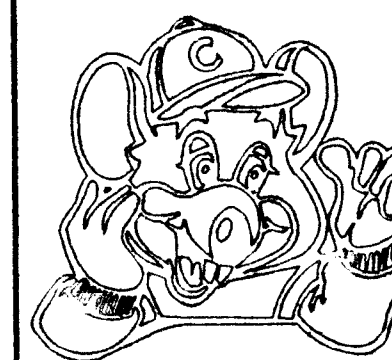

CHUCK E. CHEESE'S PIZZA. #889
6817 N. W. EXPRESSWAY
OKLAHOMA CITY, OK 73132
C. E. C. ENTERTAINMENT, INC.
4441 WEST AIRPORT FREEWAY
IRVING, TEXAS 75062

ARCHITECTURE - PLANNING - DESIGN
C.T. CHANG AIA
1010 EULESSA BOULEVARD, SUITE 110
EULESSA, TX 76040

OKLAHOMA CITY, OK
SECTIONS AND DETAILS

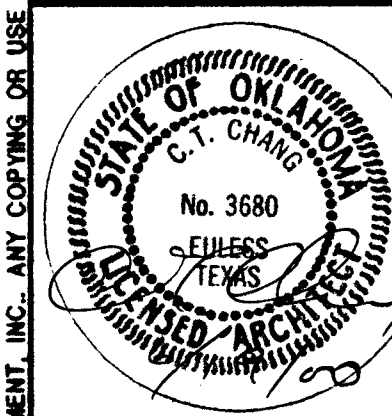

Date: 03/28/00
Revisions:
06/16/00 REVISIONS -
CITY COMMENTS
Project Number: SB-889
Sheet Number: A5 of 8

